


T.15S.R.3W.W.M.

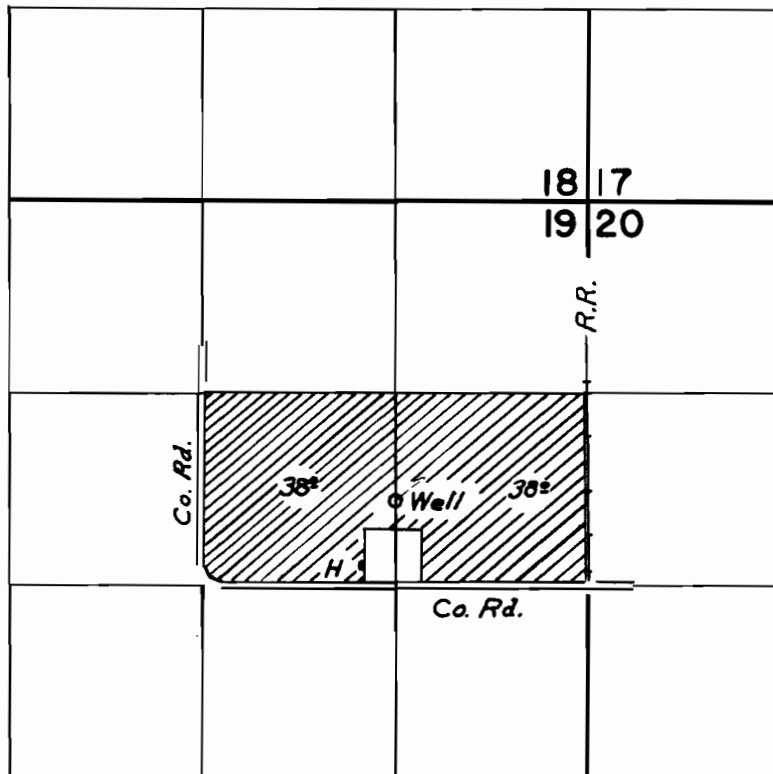

FINAL PROOF SURVEY UNDER

Application No. G-1456 Permit No. G-1340
IN NAME OF

Edgar B. Grimes

Surveyed April 5, 1962, by Thomas R. Lauer