


T. 10S. R. 3W.W. M.

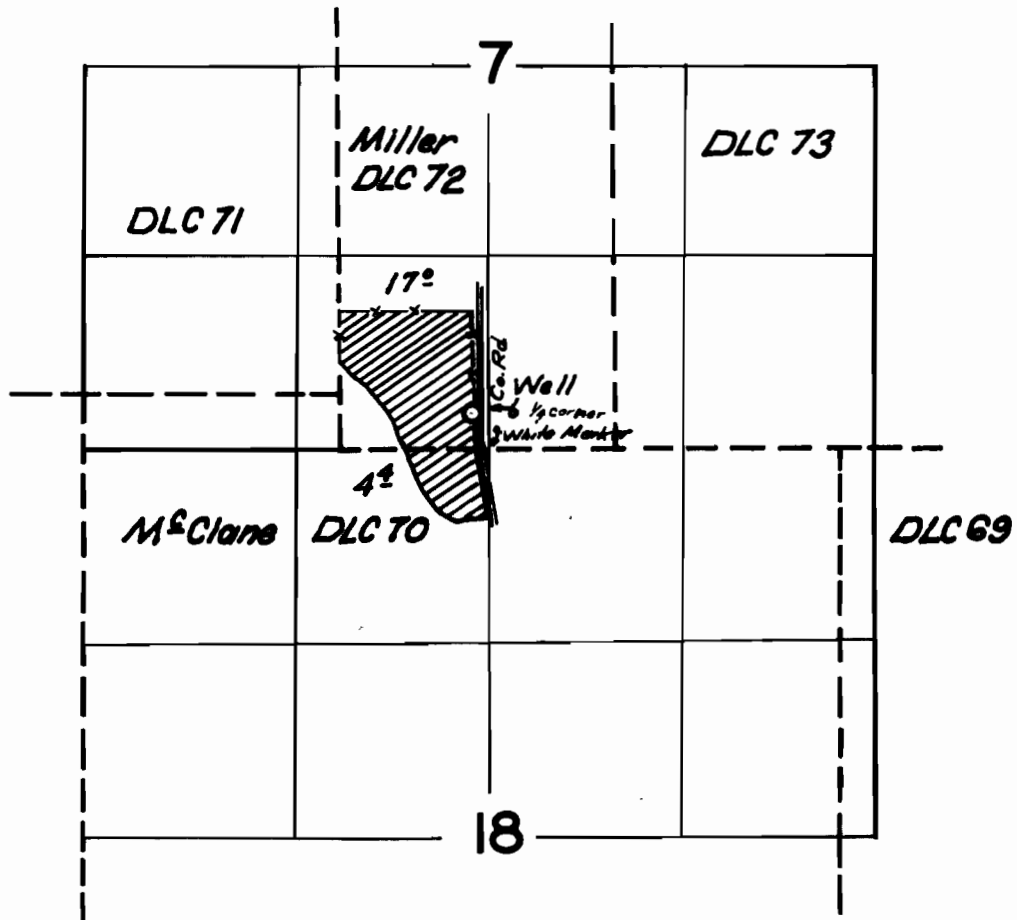

FINAL PROOF SURVEY
UNDER

Application No. G-1503 Permit No. G-1375
IN NAME OF

Walter & Helen Mangnell

Surveyed 5 April 1962, by Carl R. Baker.