


T. 11 S. R. 2 W. W. M.

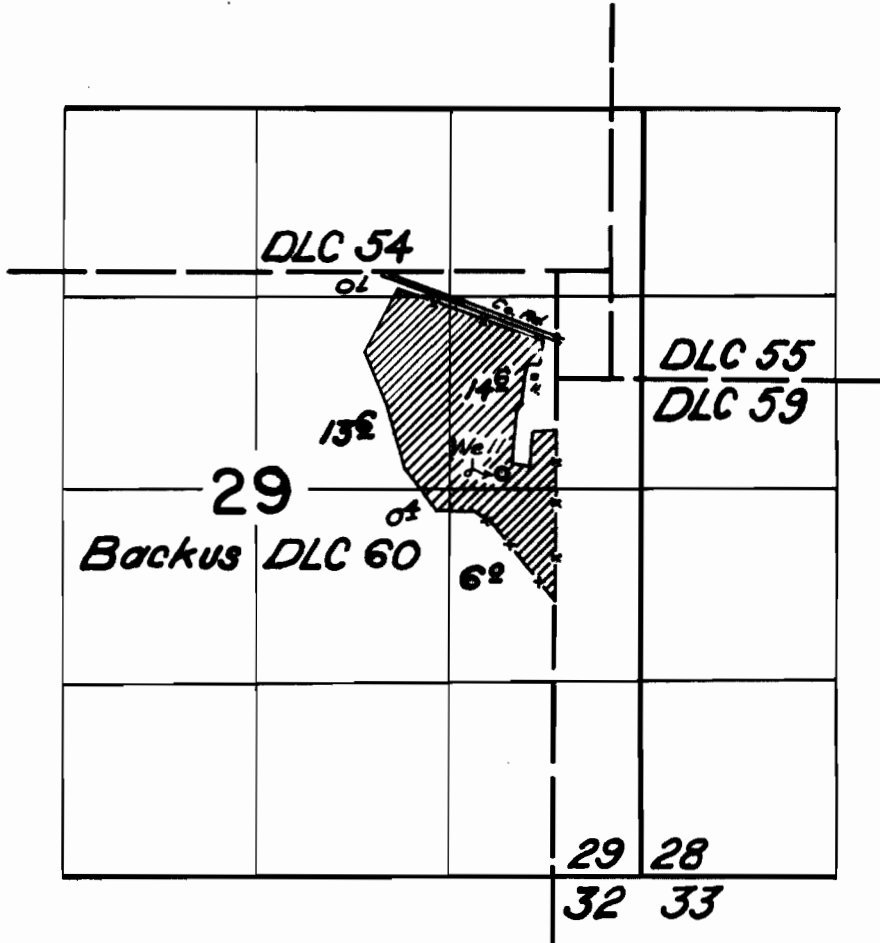

FINAL PROOF SURVEY
UNDER

Application No. *G-150B* Permit No. *G-1379*
IN NAME OF

L.H. & Elsie Hollingsworth

Surveyed *28 Mar 1962*, by *Carl R. Baker*