


T.14S.R.1E.W.M.

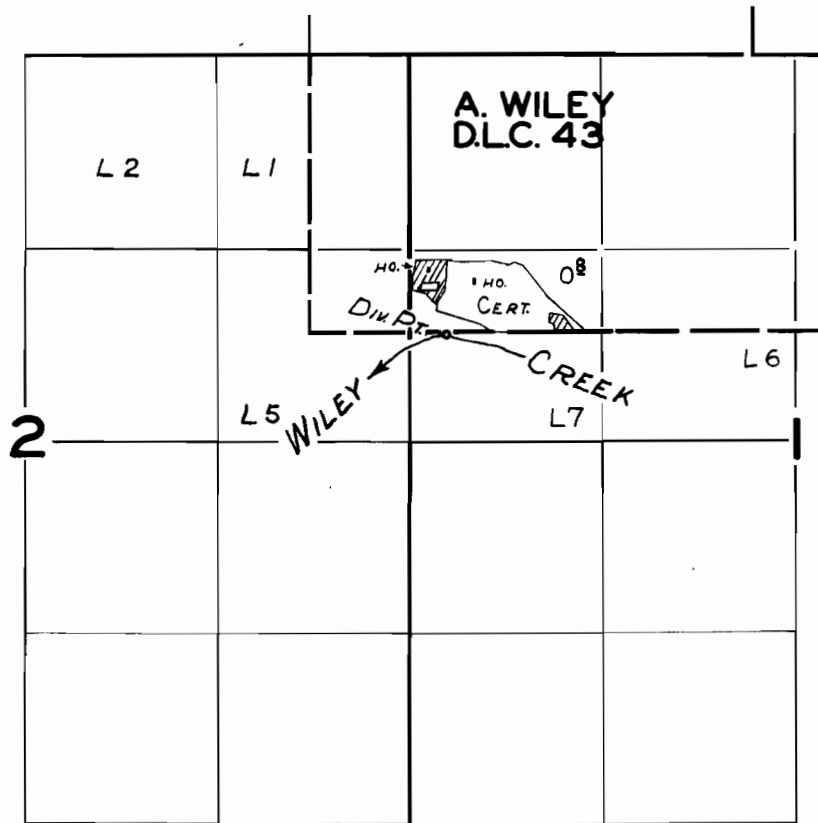

FINAL PROOF SURVEY UNDER

Application No. 30975..... Permit No. 24358.....
IN NAME OF

WALTER & BETTY FORSBERG

Surveyed *JUNE 22, 1961*, by *M. BISH*.....