


T. 9 S. R. 1 W. W.M.

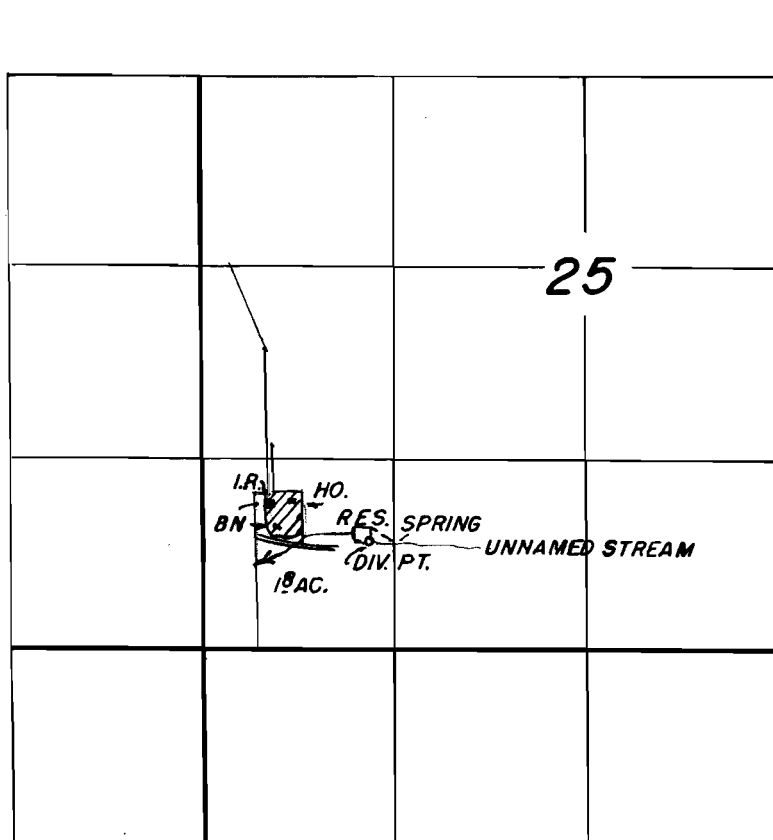

FINAL PROOF SURVEY
UNDER

R-32601 *R-2181*
Application No. 32602 Permit No. 25659
IN NAME OF

FRANCIS KREILICH

Surveyed May 16 1961, by _____