


T. 13S. R. 1 E. W. W.

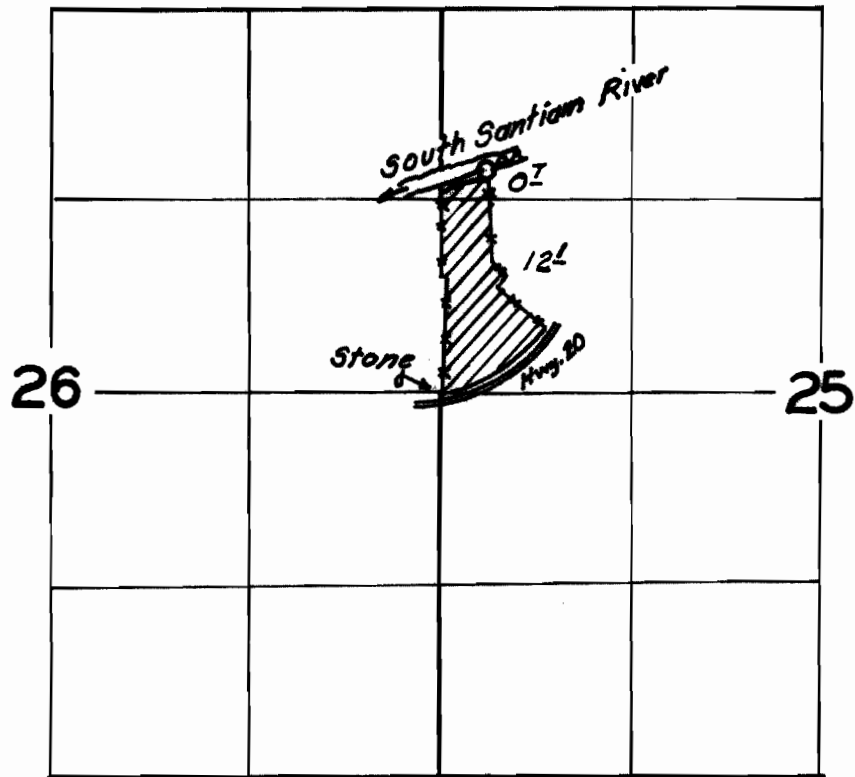

**FINAL PROOF SURVEY**  
UNDER

Application No. 33082 Permit No. 26160  
IN NAME OF

Phillipe W. & Eleanor P. Barnes

Surveyed 2 Apr. 1962, by Carl R. Baker.