


SEC. 2 T. 4-S. R. 2 W.

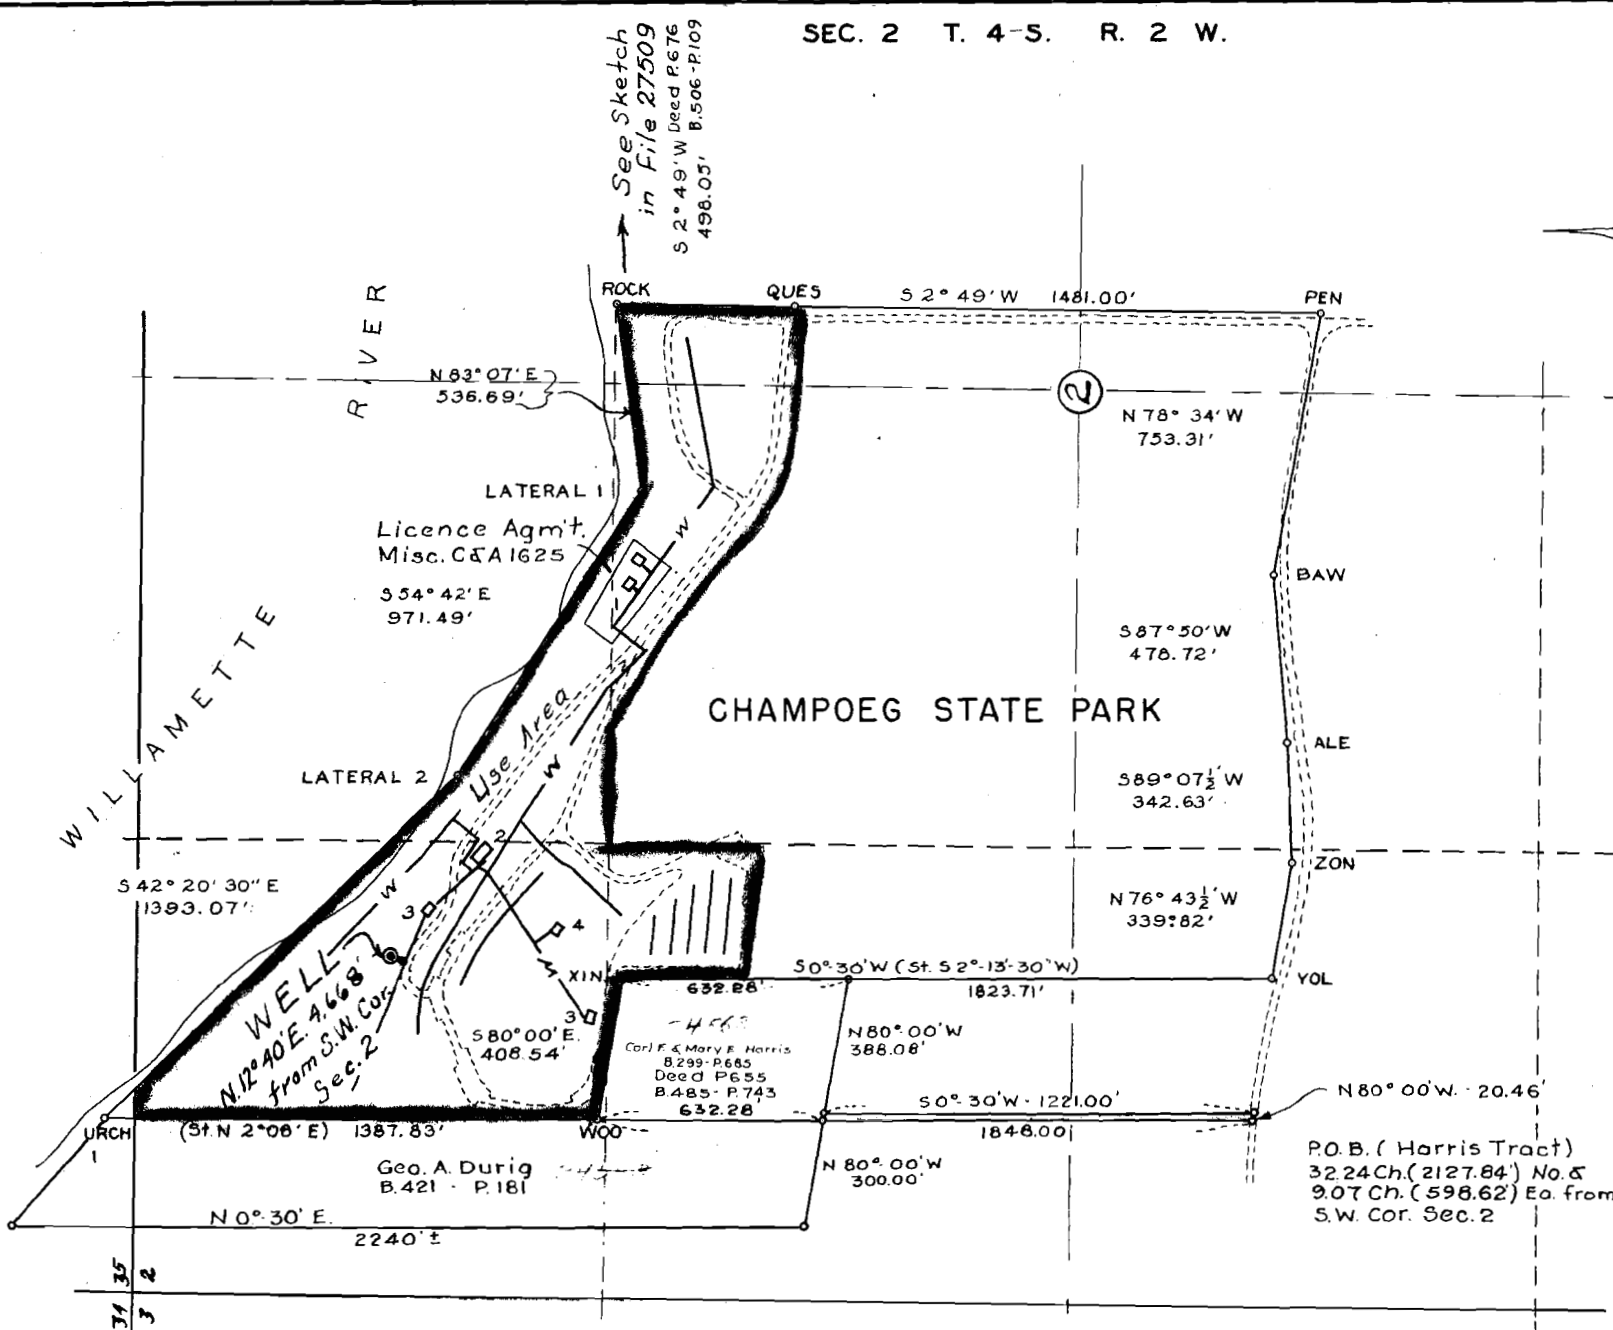

- LEGEND
- 1 D.A.R. PLOT
 - 2 PAVILLION
 - 3 LATRINE
 - 4 KITCHEN SHELTER

P.O.B. (Harris Tract)
 32.24 Ch. (2127.84') No. 5
 9.07 Ch. (598.62') Ea. from
 S.W. Cor. Sec. 2

OREGON STATE HIGHWAY DEPARTMENT	
For	WELL PERMIT
	CHAMPEOG PARK
	W S
	M C
County	MARION
Scale 1" = 400'	Date 7-28-54

Application No. G-1101
 Permit No. G-950

7/22/58