


T.4S.R.28&3W.W.M.

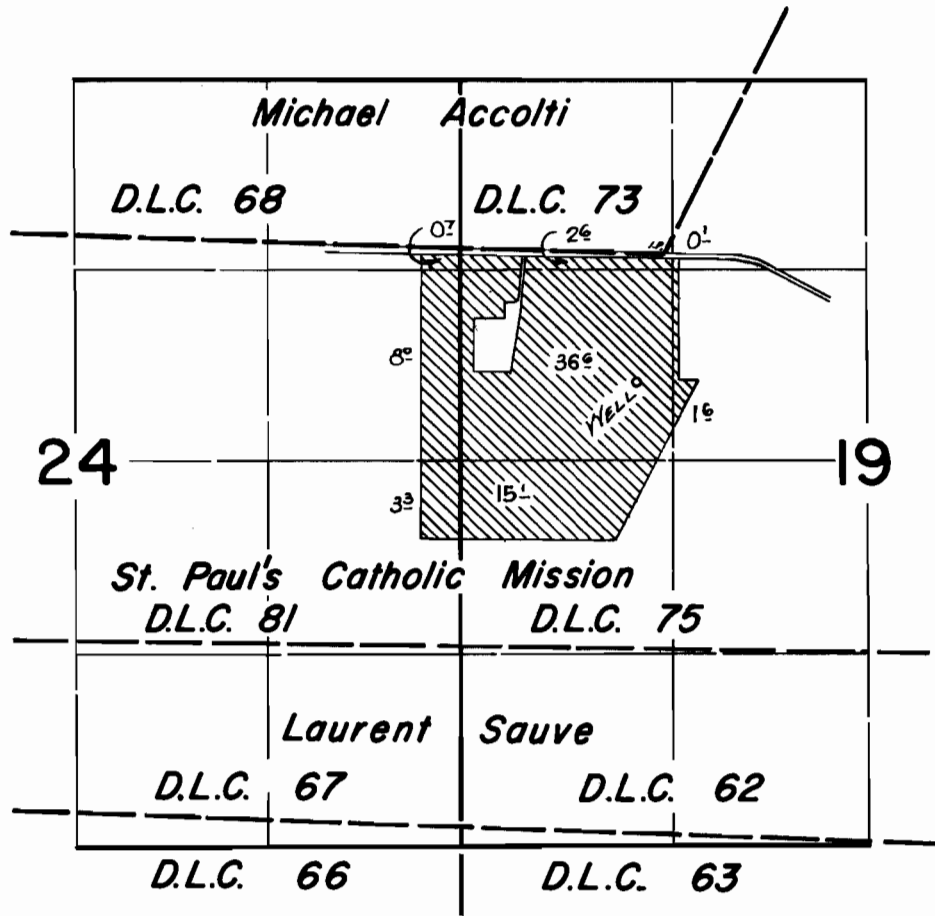

FINAL PROOF SURVEY
UNDER

Application No. G-1279... Permit No. G-1086...
IN NAME OF

DON E. BUCKLEY

Surveyed March 22 1962., by