


T.5S.R.1W.W.M.

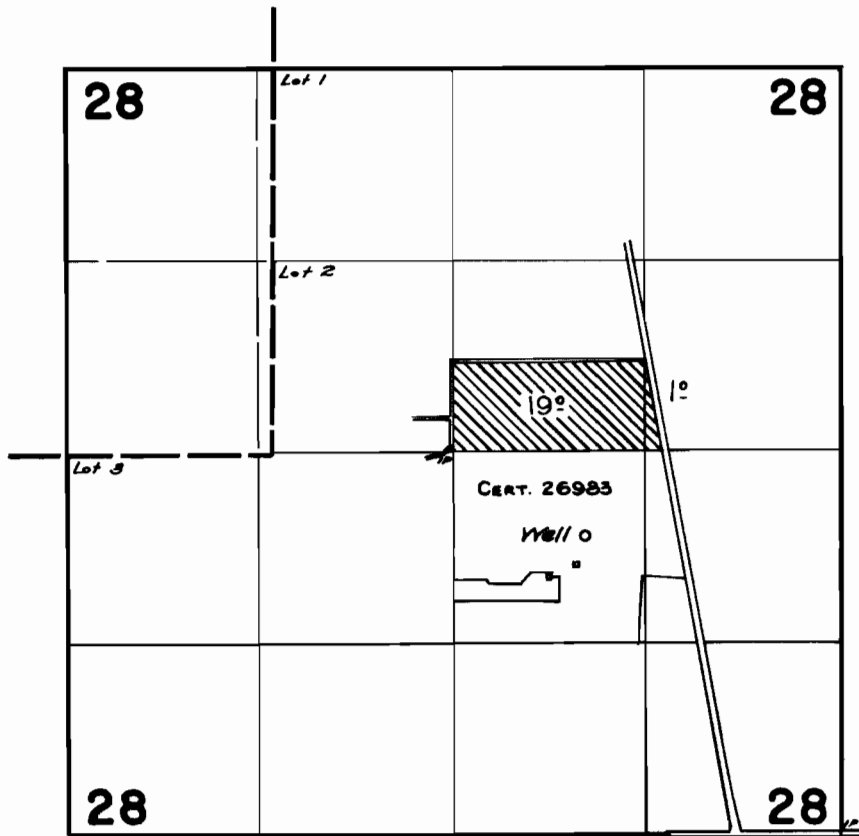

FINAL PROOF SURVEY
UNDER

Application No. G:1458... Permit No. G:1341...
IN NAME OF

.....**ALFRED JUVE**.....

Surveyed March 21 1962, by *R. Jackson*