


T.6S.R.2W.W.M.

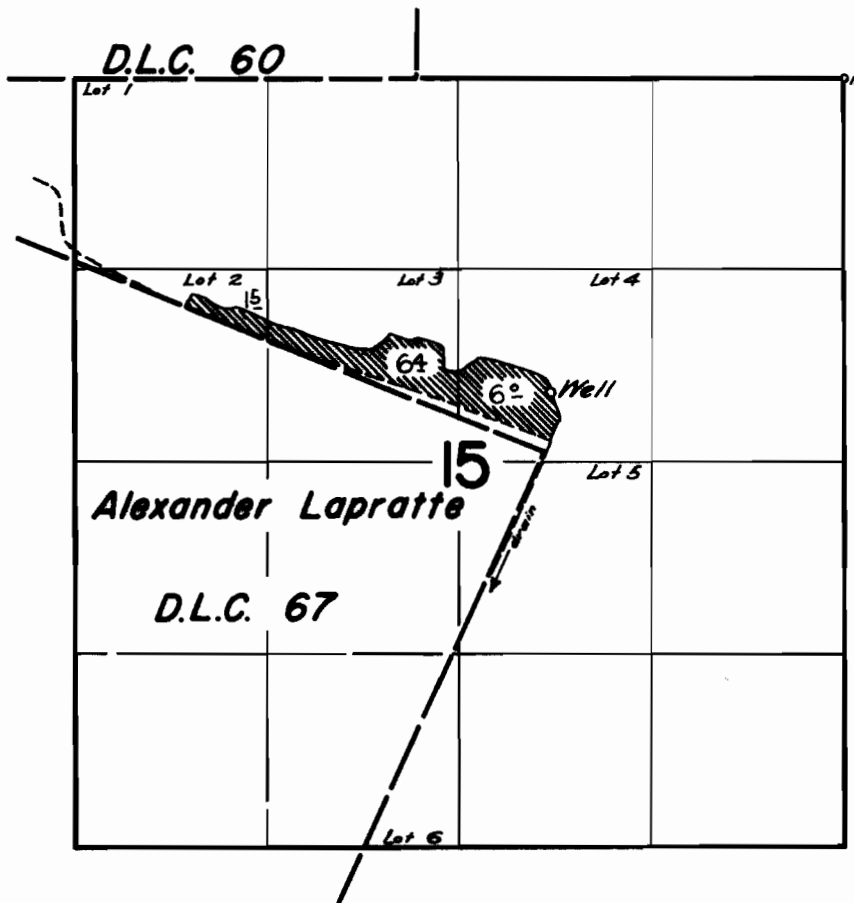

FINAL PROOF SURVEY
UNDER

Application No. G-1522 Permit No. G-1386.
IN NAME OF

MAX BIBBY

Surveyed March 20 1962, by