


T. 9 S. R. 1 W. W. M.

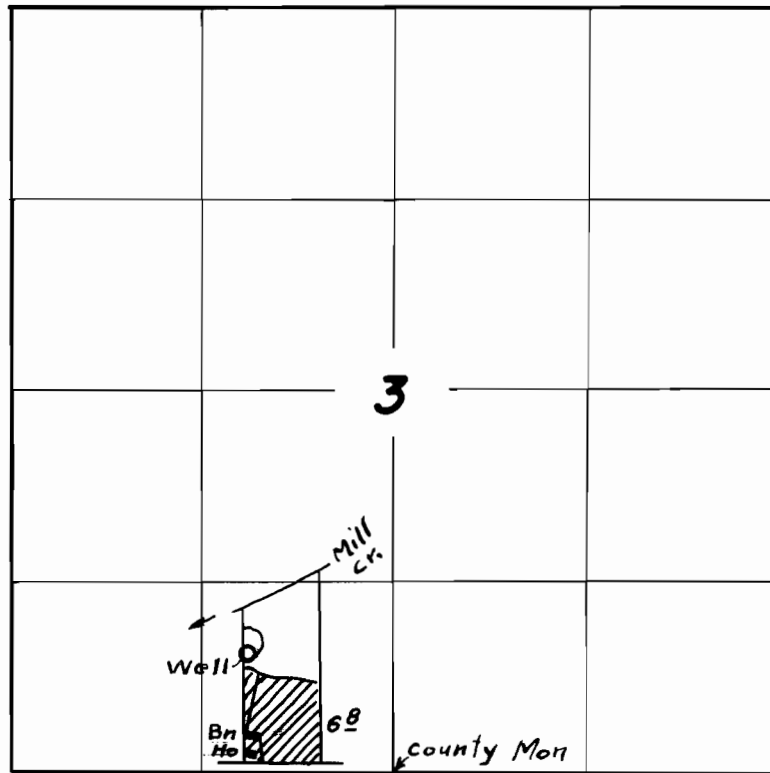

**FINAL PROOF SURVEY
UNDER**

Application No. G-1783 Permit No. G-1635
IN NAME OF

LEO BOEDIGHEIMER

Surveyed June 29 1962, by FL Stegmann