


T.5S.R.1W.W.M.

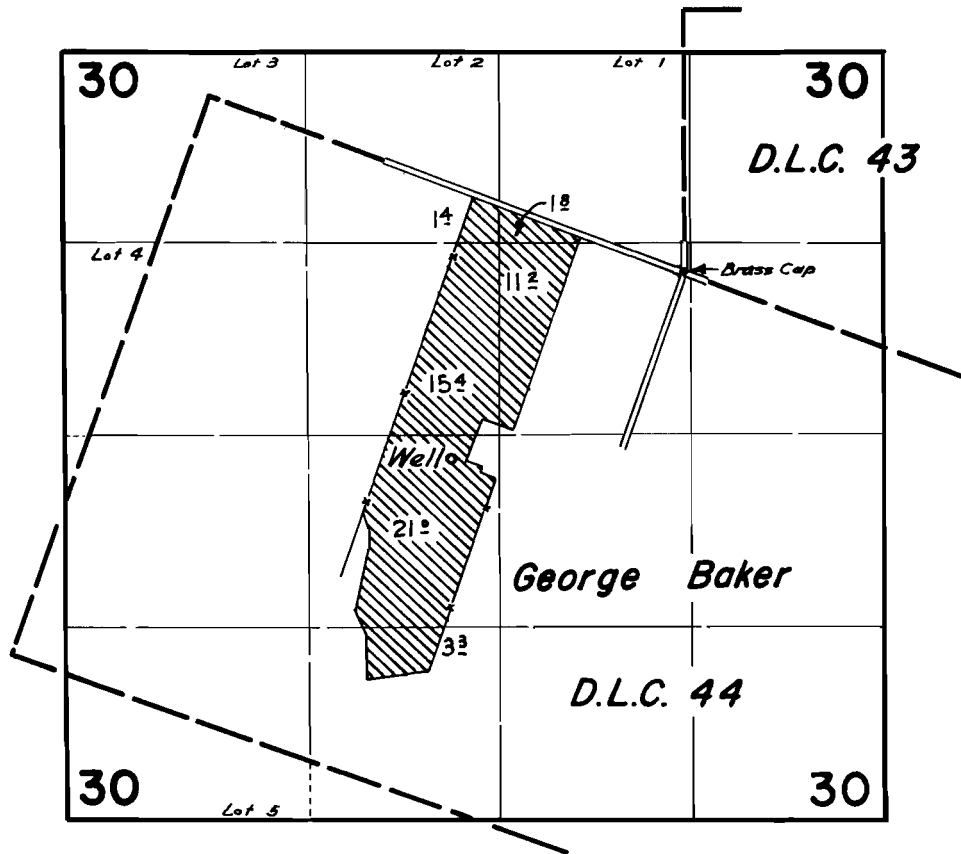

FINAL PROOF SURVEY
UNDER

Application No. G-2023. Permit No. G-1919....
IN NAME OF

CARL B. LEDER

Surveyed March 27, 1962, by *[Signature]*