


T. 9 S. R. 1 W. W. M.

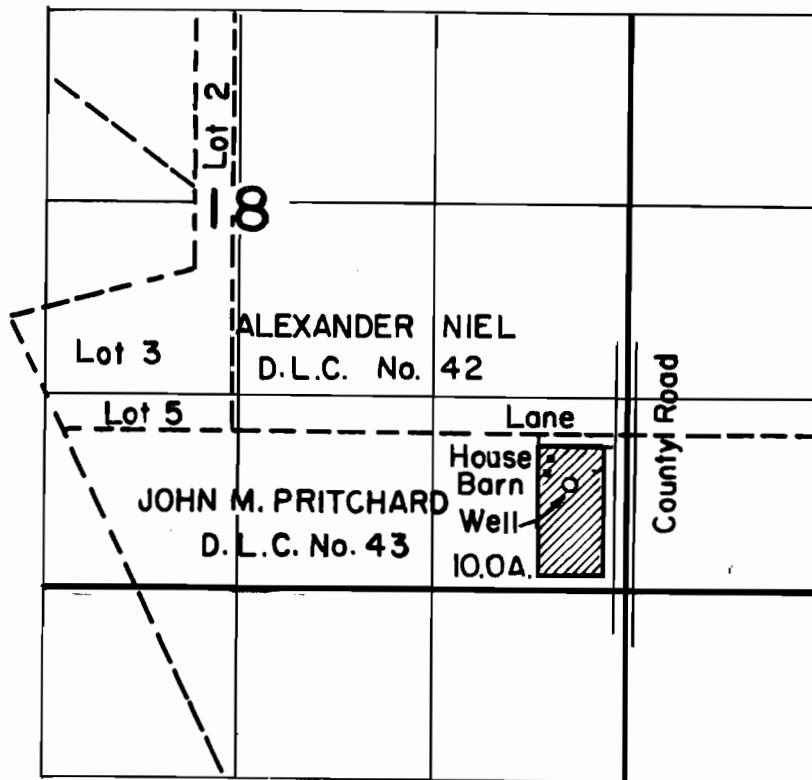

FINAL PROOF SURVEY
UNDER

Application No. G-2143 Permit No. G-1979
IN NAME OF

Raymond Schrock

Surveyed October 17 1962, by *Floyd L. Sigmond*