


T.9S.R.4E.W.M.

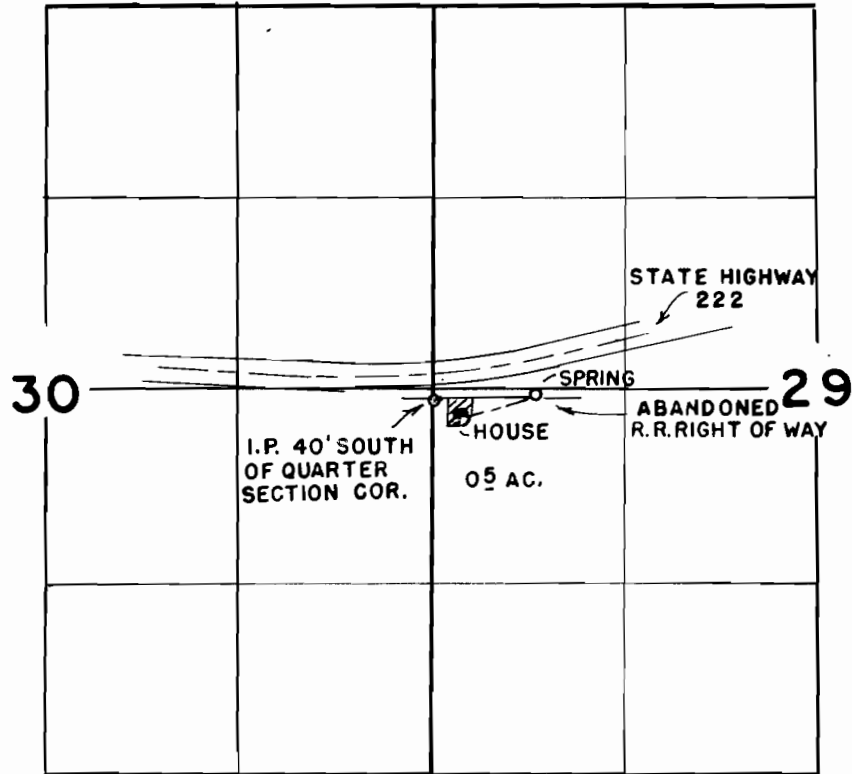

FINAL PROOF SURVEY
UNDER

Application No. 32532 Permit No. 25695
IN NAME OF

ARCHIE POYNOR

Surveyed October 22 1962, by *F.L. Siegmund*