


# T. 8 S. R. 1 W. W. M.

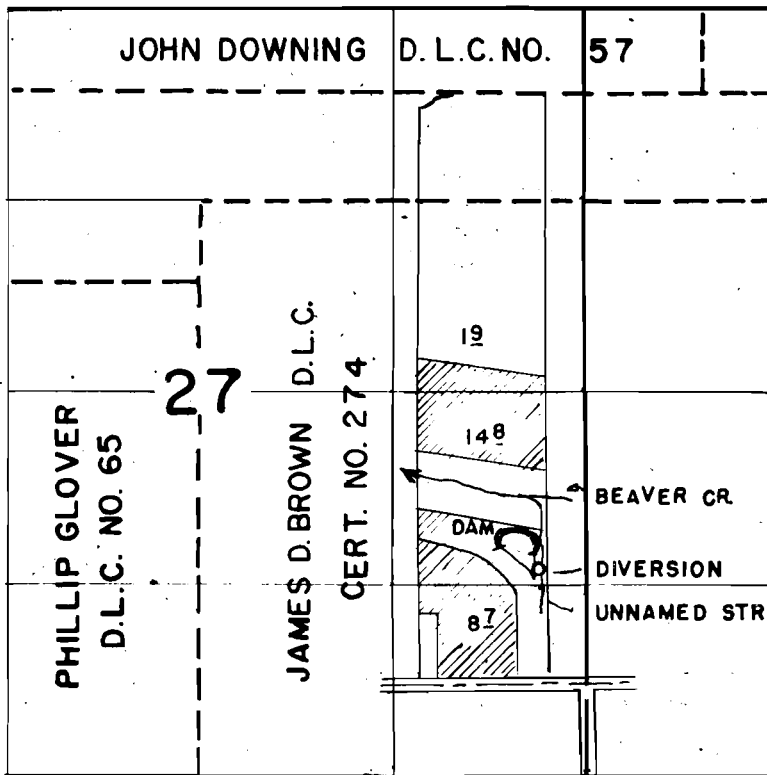

## FINAL PROOF SURVEY UNDER

Application No. **R-32465** **32466** Permit No. **R-2229** **26048**  
IN NAME OF

**HILDA SHUMACHER**

Surveyed Oct. 19 1962, by *Gloyd L. Siegmund*