


T. 8 S. R. 1 W. W. M.

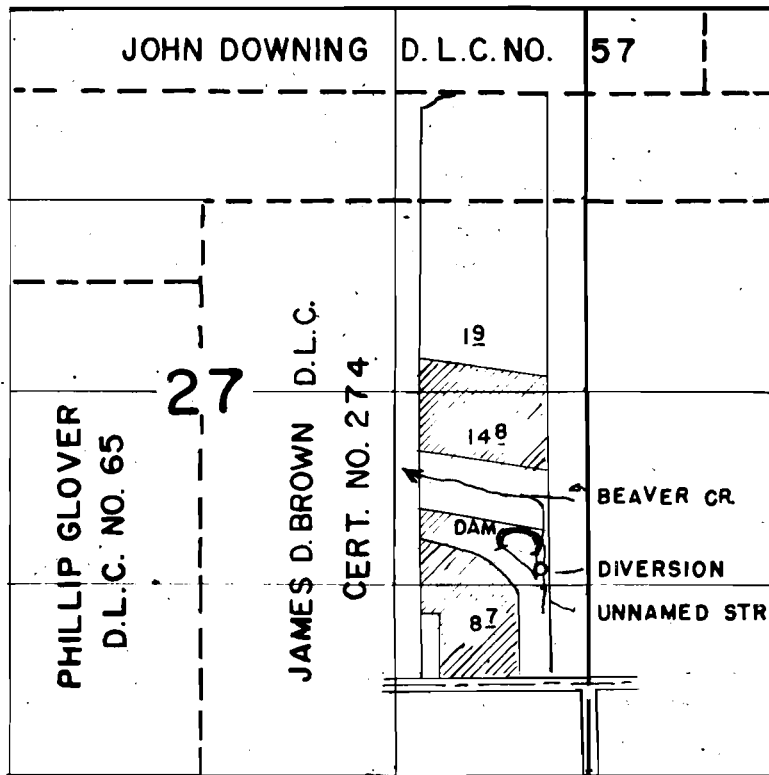

FINAL PROOF SURVEY UNDER

R-32465 R-2229
 Application No. 32466 Permit No. 26048
 IN NAME OF

HILDA SHUMACHER

Surveyed Oct. 19 1962, by *Floyd L. Siegmund*