


T.4S.R.2W.W.M.

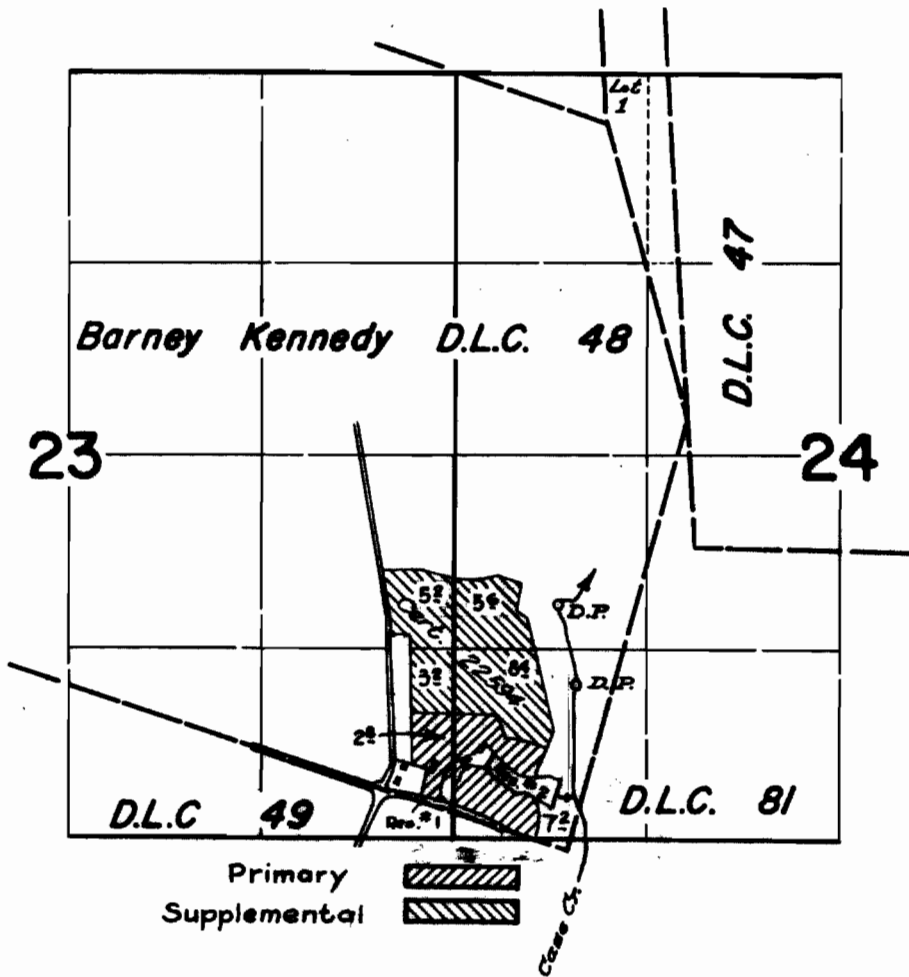

FINAL PROOF SURVEY UNDER

R-52990 R-2236
Application No. 32991 Permit No. 26120
IN NAME OF

HENRY WILMES

Surveyed March 27, 1962, by

A. Jackson