


T. 3 S. R. 9 W. W. M.

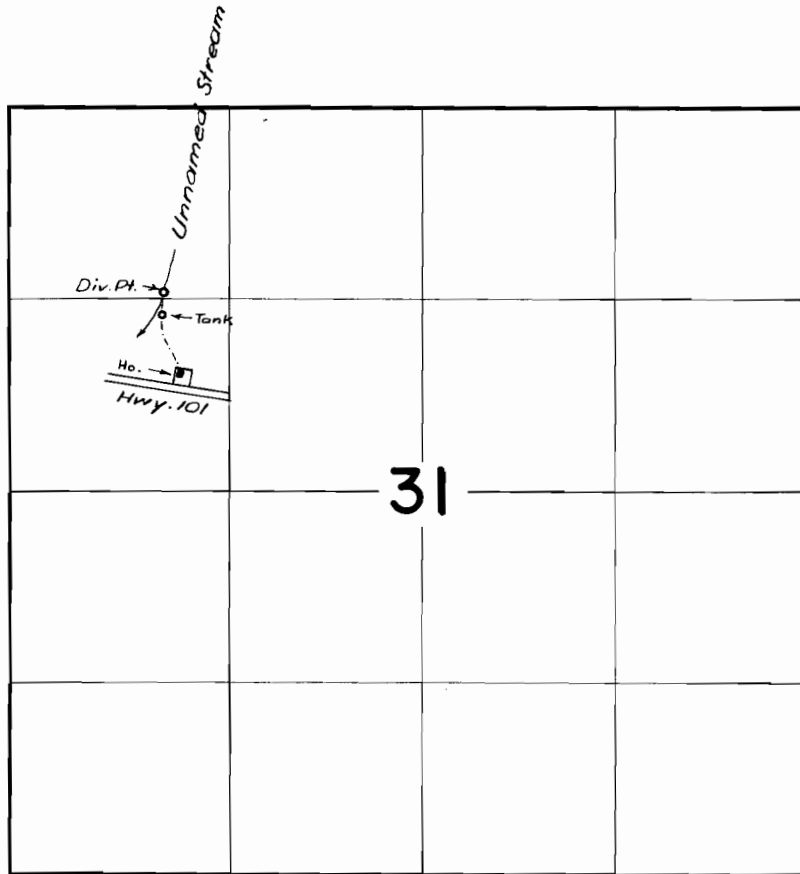

**FINAL PROOF SURVEY**  
UNDER

Application No. 32209 Permit No. 25414  
IN NAME OF

GEORGE E. WINEGAR

Surveyed 27 JUNE 1961, by m. Bish