


U-711
30531

T.5&6N.R.34E.W.M.

CANCELLED

Y49 P118

T-6291

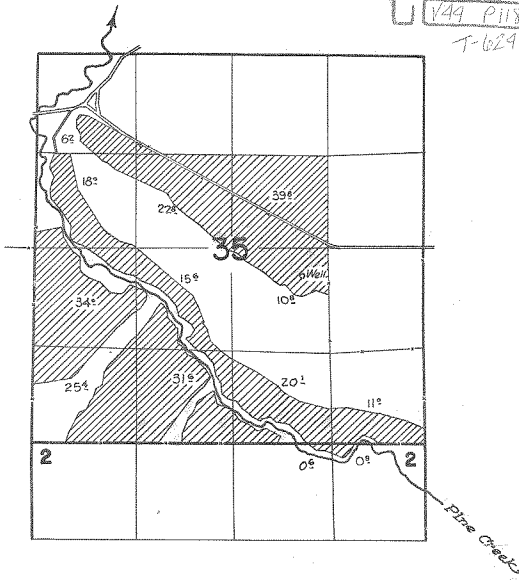

FINAL PROOF SURVEY
UNDER

Application No. U-793... Permit No. U-711.....
IN NAME OF

E. F. ARNOLD

Surveyed Sept. 15 1961, by C.O. Barfels.