

N. 89°37'W

79.77 ch.

Old Road - Vacated.

Athena-Holman Road

300' state of Oregon.
423' S. 43°42'W.
299.5'

1282'

22


North - 80.00 Chains

Bridge
Spring Iron Pin 10' S. E.
N. 46°15'W
N. 68°30'W 1941' From E/4 Cor.
N. 32°25'W 858' From E/4 Cor.
N. 73°40'W
N. 46°45'W 851'
2250' 464 A.
Pump Location Iron pin 10' E. of Ch. Bank
J. H. Sampson Et. al.

Stream
Small
J. H. Sampson, et. al.
S. 42°30'W
S. 32°10'W 855'

N. 89°15'W
348'
674.7'
Well
Hse.
Garage
West 3100'
20'
350'
630'

Plat of Part of
Sec. 22, T. 4 N., R. 34 E. W. M.
Umatilla Co. Ore.
Surveyed, Staked & Platted
Dec. 1949 - By W. E. O. Criger.
Scale: 1 inch = 300 Ft.
Area Const = 2.06 @ 0"
Totals = 464 A = 704 A - For Water
Athena
N. E. Corner of NW/4 of Sec. 22, T. 4 N., R. 34 E. W. M.
Iron Pin in place.

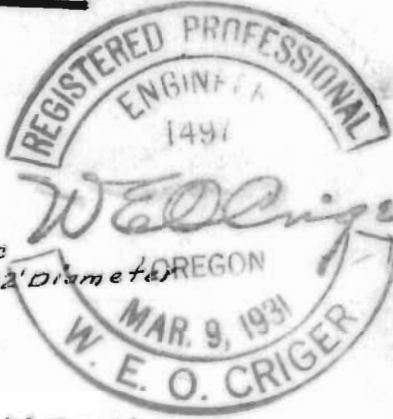

Y. P. Winans

Y. P. Winans.

I, W. E. O. Criger, of Pendleton, Ore., do hereby certify that this map was made from notes taken during an actual survey made by me on Jan. 9th 1953; that the monument shown on this map consisting of a 3/4" iron pipe 30" long - Bearing N. 32°25'W, 858' From E/4 corner on E Sec. 22 - Also N. 68°30'W, 1941' From E/4 Corner of Sec. 22. Pump Location; as indicated on plat.

W. E. O. Criger

N. 89°45'W - 79.84 Ch. (on So. Sec. Line)

Y. P. Winans.

Application No. 28110
Permit No. 22129
MAR 20 1953
STATE ENGINEER
SALEM, OREGON

Jas. H. Sampson - Ph. 23 F 11 Athena