


T. 4S. R. 3 E. W. M.

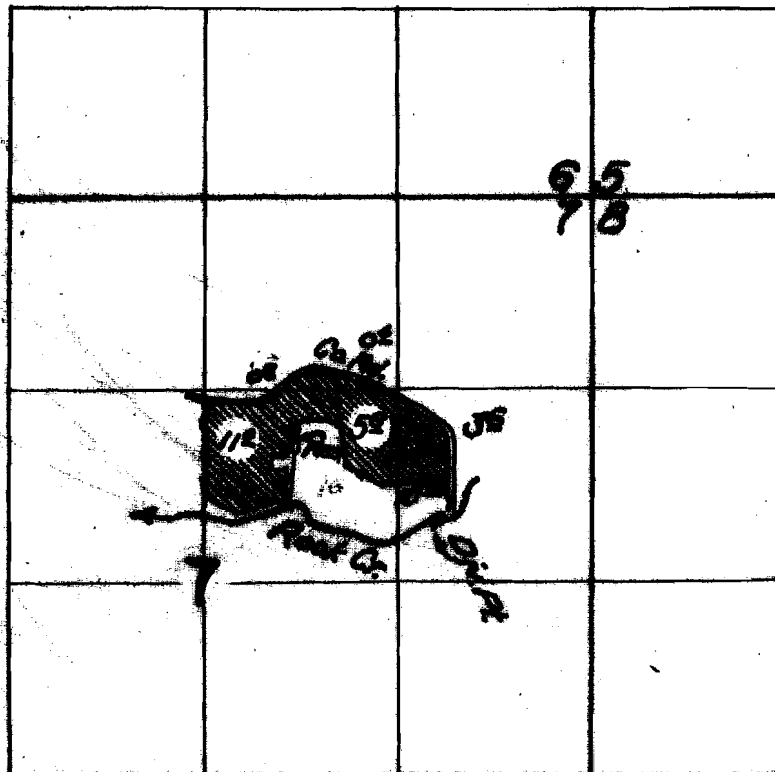

FINAL PROOF SURVEY
UNDER

Application No. ³¹⁵⁸⁹~~P. 31589~~ Permit No. ²⁴⁹²⁰~~P. 2024~~
IN NAME OF

John Wiegele

Surveyed ~~on~~ ^{at} Mar. 1968, by Carl B. Baker