


T. 4S. R. 3 E. W. M.

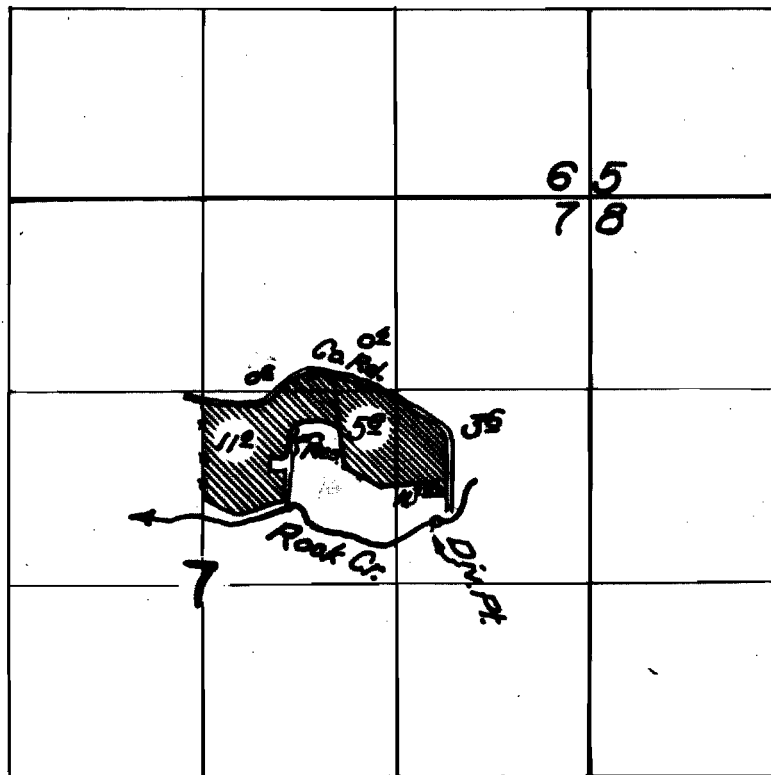

FINAL PROOF SURVEY
UNDER

Application No. 31589 Permit No. 24920
IN NAME OF

John Wiegele

Surveyed 23 Mar 1962, by Carl R. Baker