


T.14S.R.7W.W.M.

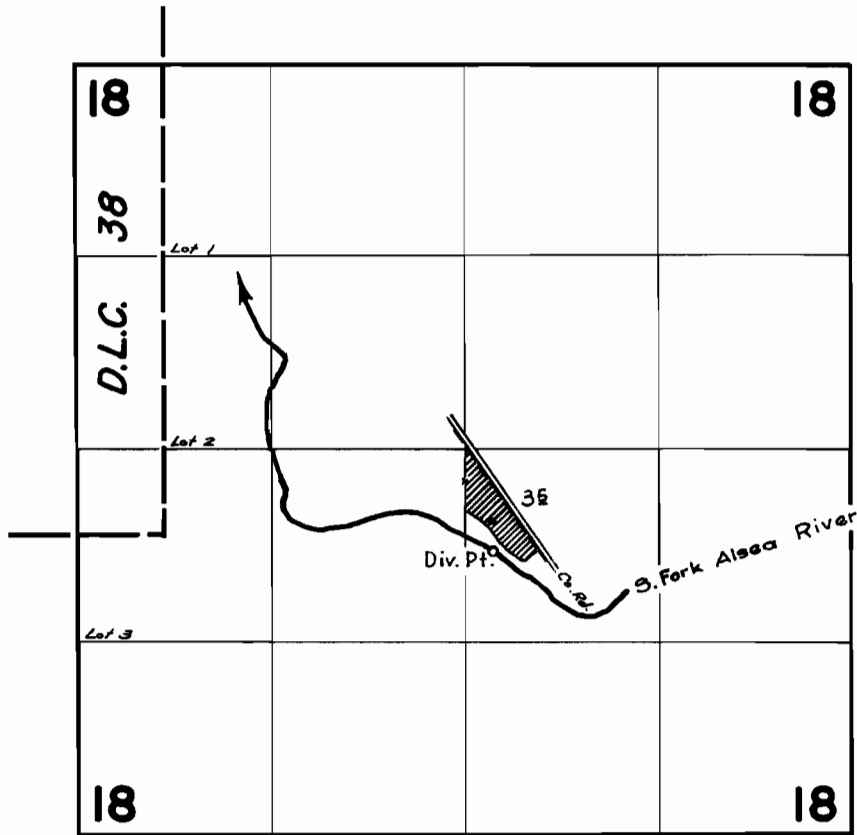

FINAL PROOF SURVEY
UNDER

Application No. 25425.. Permit No. 20002..
IN NAME OF

.....**HAROLD BRADLEY**.....

Surveyed June 13, 1961., by C.O. Bartels..