


# T. 4S. R. 1E. W. M.

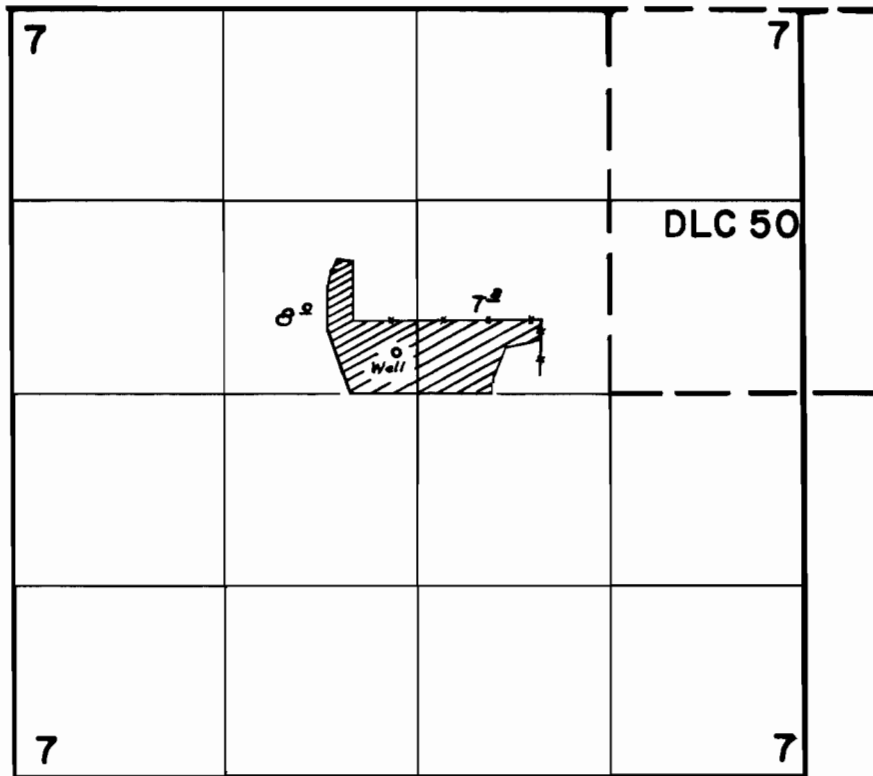

## FINAL PROOF SURVEY UNDER

Application No. G-1170 Permit No. G-915  
IN NAME OF

Albert C. Workman

Surveyed March 22, 1962, by Thomas C. Lane