


T. 5S. R. 1E. W. M.

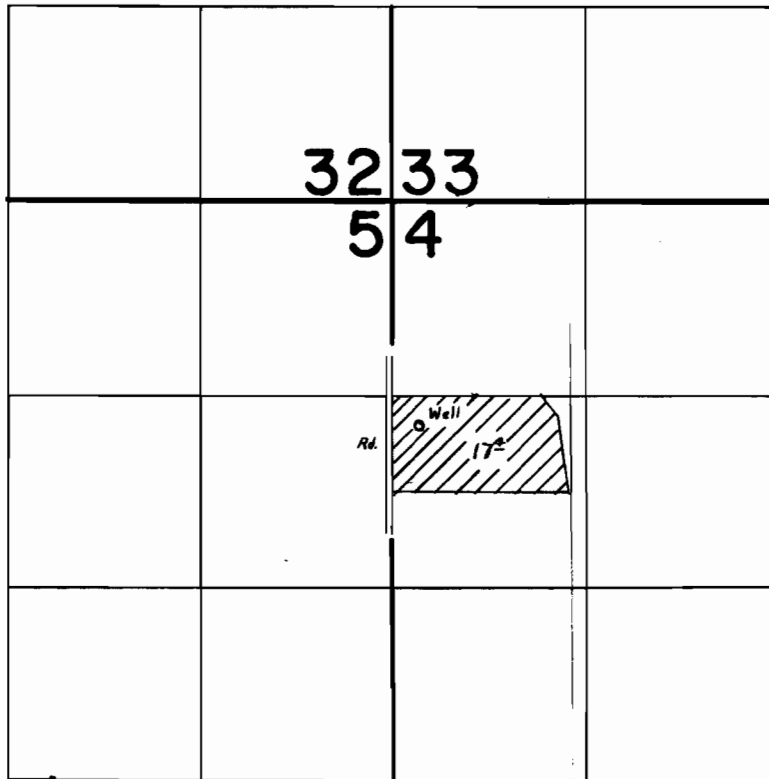

FINAL PROOF SURVEY UNDER

Application No. G-1815 Permit No. G-1660
IN NAME OF

Alvin E. Morton

Surveyed March 18, 1962, by C.A. Baker