


T.4S.R.3E.W.M.

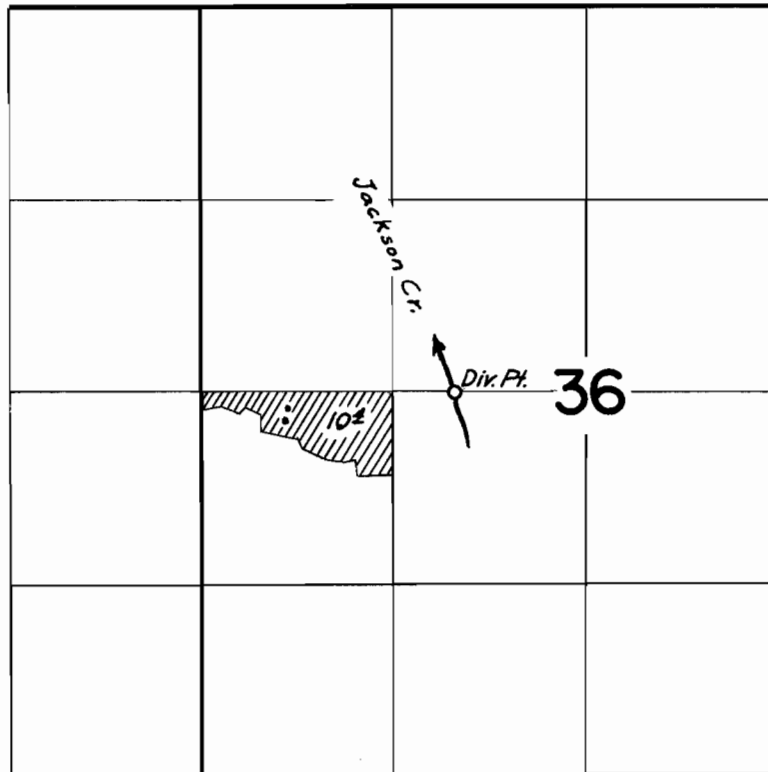

FINAL PROOF SURVEY
UNDER

Application No. 31369 Permit No. 24733
IN NAME OF

Walter Raymond Watson

Surveyed April 23 1962, by Thomas R. Lauer