


T. 3S. 3E. W.M.

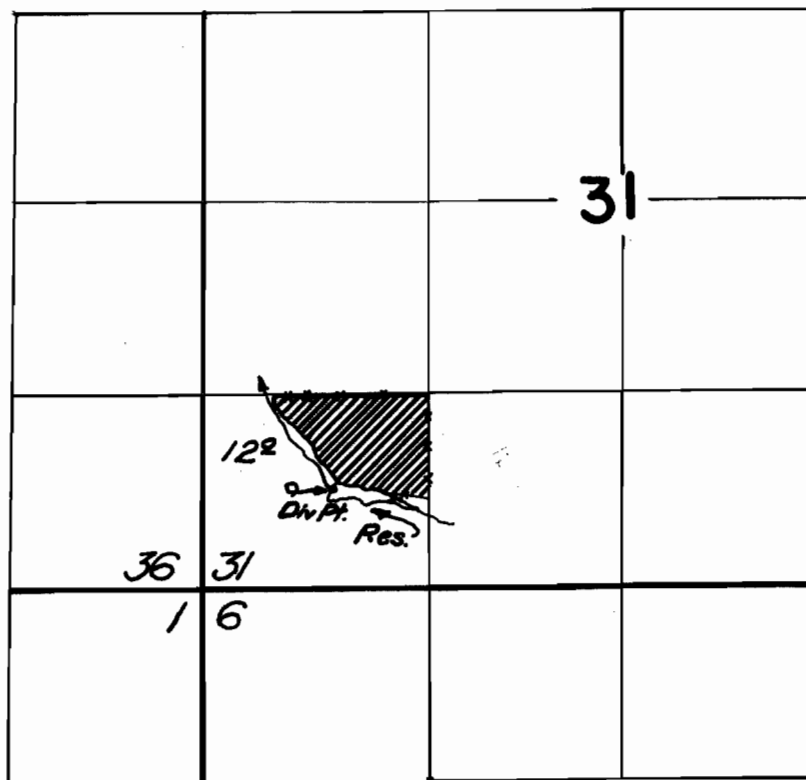

FINAL PROOF SURVEY
UNDER

Application No. 31766 Permit No. 25086
R-31765 R-2066
IN NAME OF

Robert W. Wicklund

Surveyed 23 Mar 1962, by Carl R. Baker