


T.2S.R.1E.W.M.

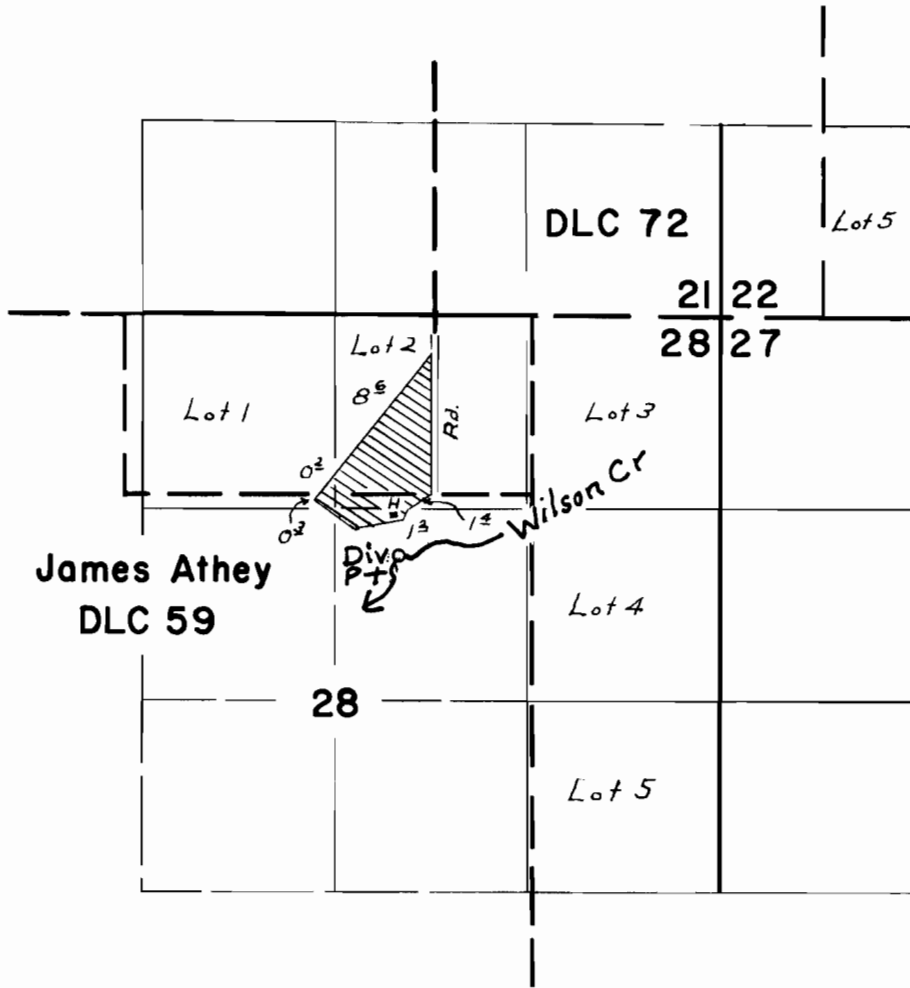

FINAL PROOF SURVEY UNDER

Application No. 34186 Permit No. 26938
IN NAME OF

Jerry Fiala

Surveyed March 23 1962, by Thomas H. Lewis