


T.28-29S.R.12 W.W.M.

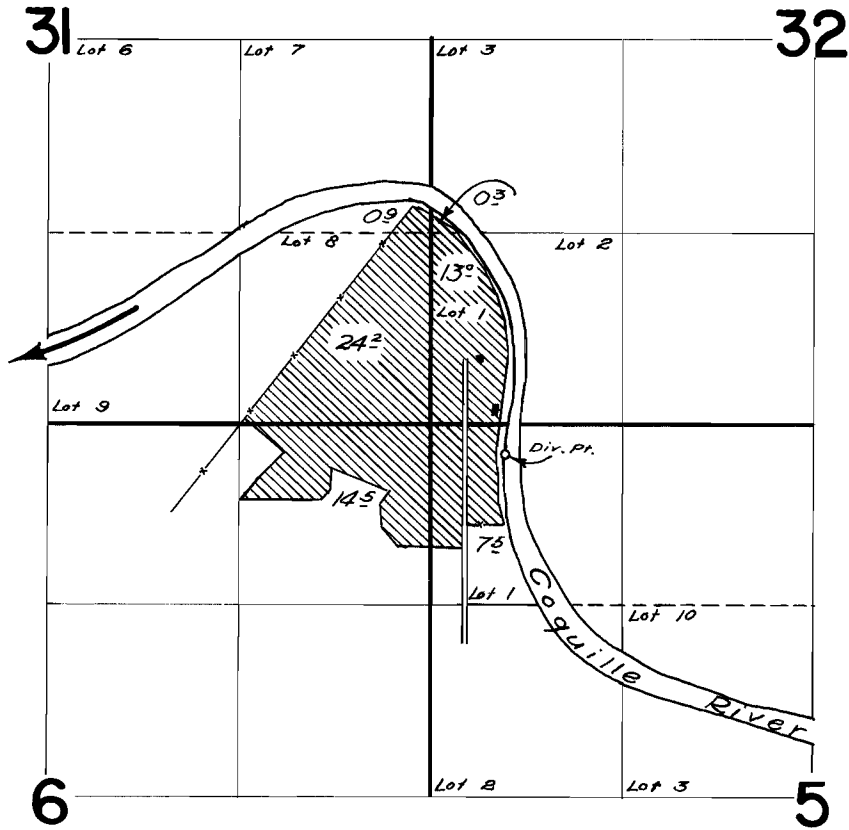

FINAL PROOF SURVEY UNDER

Application No. 31535 Permit No. 24871
IN NAME OF

Mrs. H. V. Neuhaus & Mrs. E. B. Eickmeyer

Surveyed August 9, 1961, by C. O. Bartels.