


T.29S.R.4W.W.M.

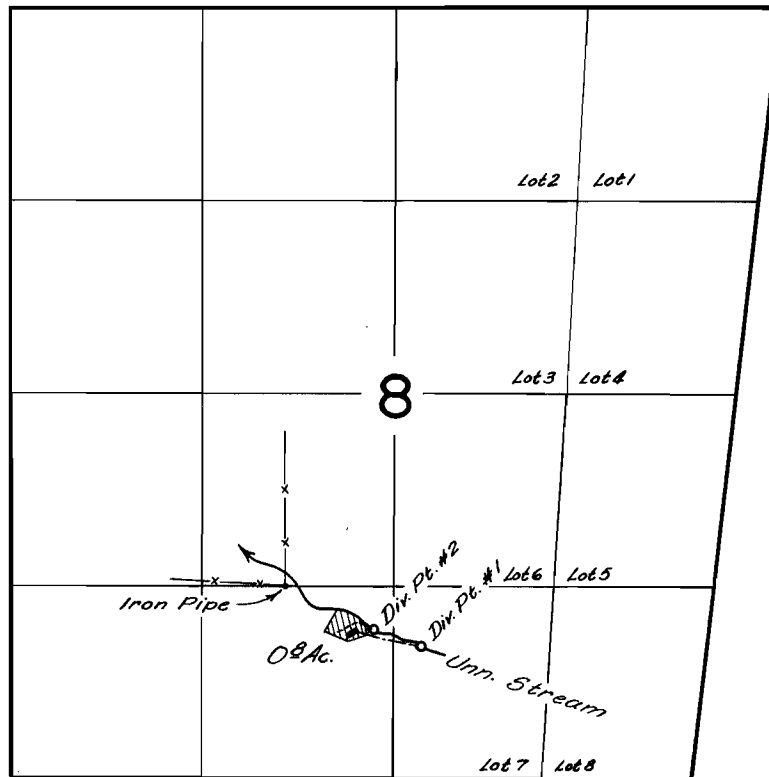

FINAL PROOF SURVEY
UNDER

Application No. 29520 Permit No. 23674
IN NAME OF

Carl J. Starbuck

Surveyed Aug. 29 1962, by C.O. Bartels