




RECEIVED
DEC 26 1961
STATE ENGINEER
KALEM, OREGON

THOMAS WITTED D.L.C. No.

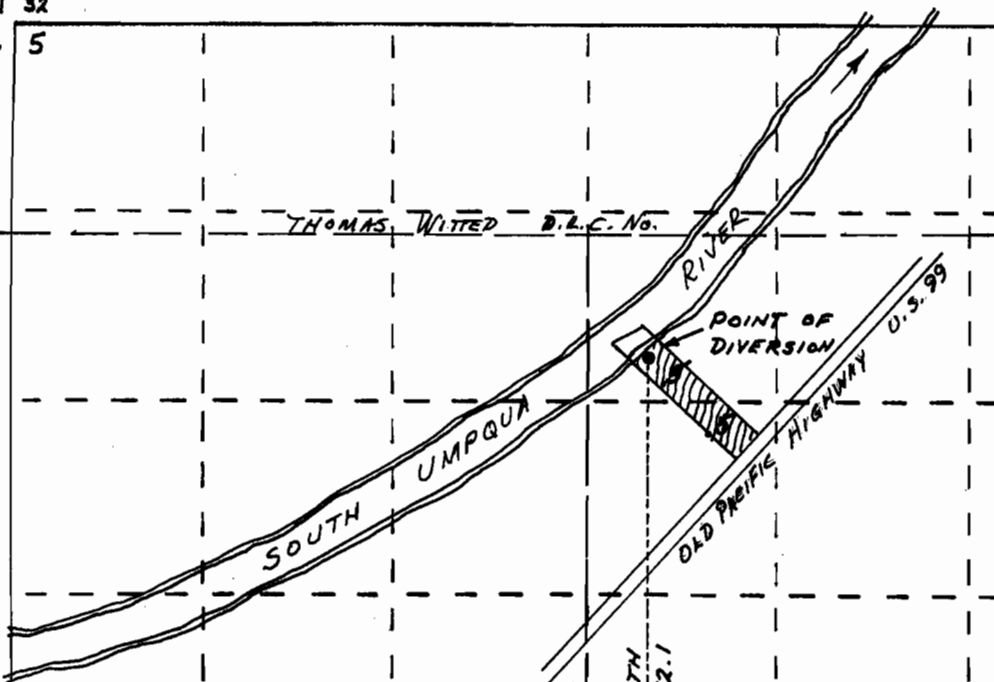

SW CORNER
JAMES WEAVER
D.L.C. No. 37
EAST
217.6

D.L.C. No. 37

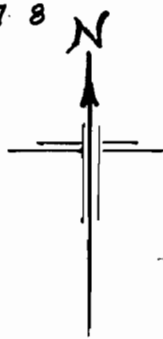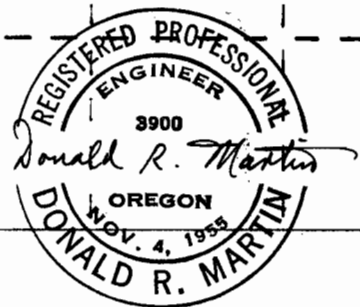

WATER DIVERSION MAP
EDWARD A. & RHODA A. LAMBERT Application No. 37274
RIDDLE, OREGON. Permit No. 27769

JAMES WEAVER D.L.C. No. 37 SEC. 5 T30S R5W W.M. DOUGLAS COUNTY, ORE.

SCALE: 8 IN. = 1 MILE

MARTIN ENGINEERING SERVICE - MYRTLE CREEK, OREGON - DECEMBER 1961

31 32
5
6 5
7 8