


T. 16 S. R. 34 E. W.M.
T. 16 S. R. 35 E. W.M.

← PRAIRIE CITY 28 MILES

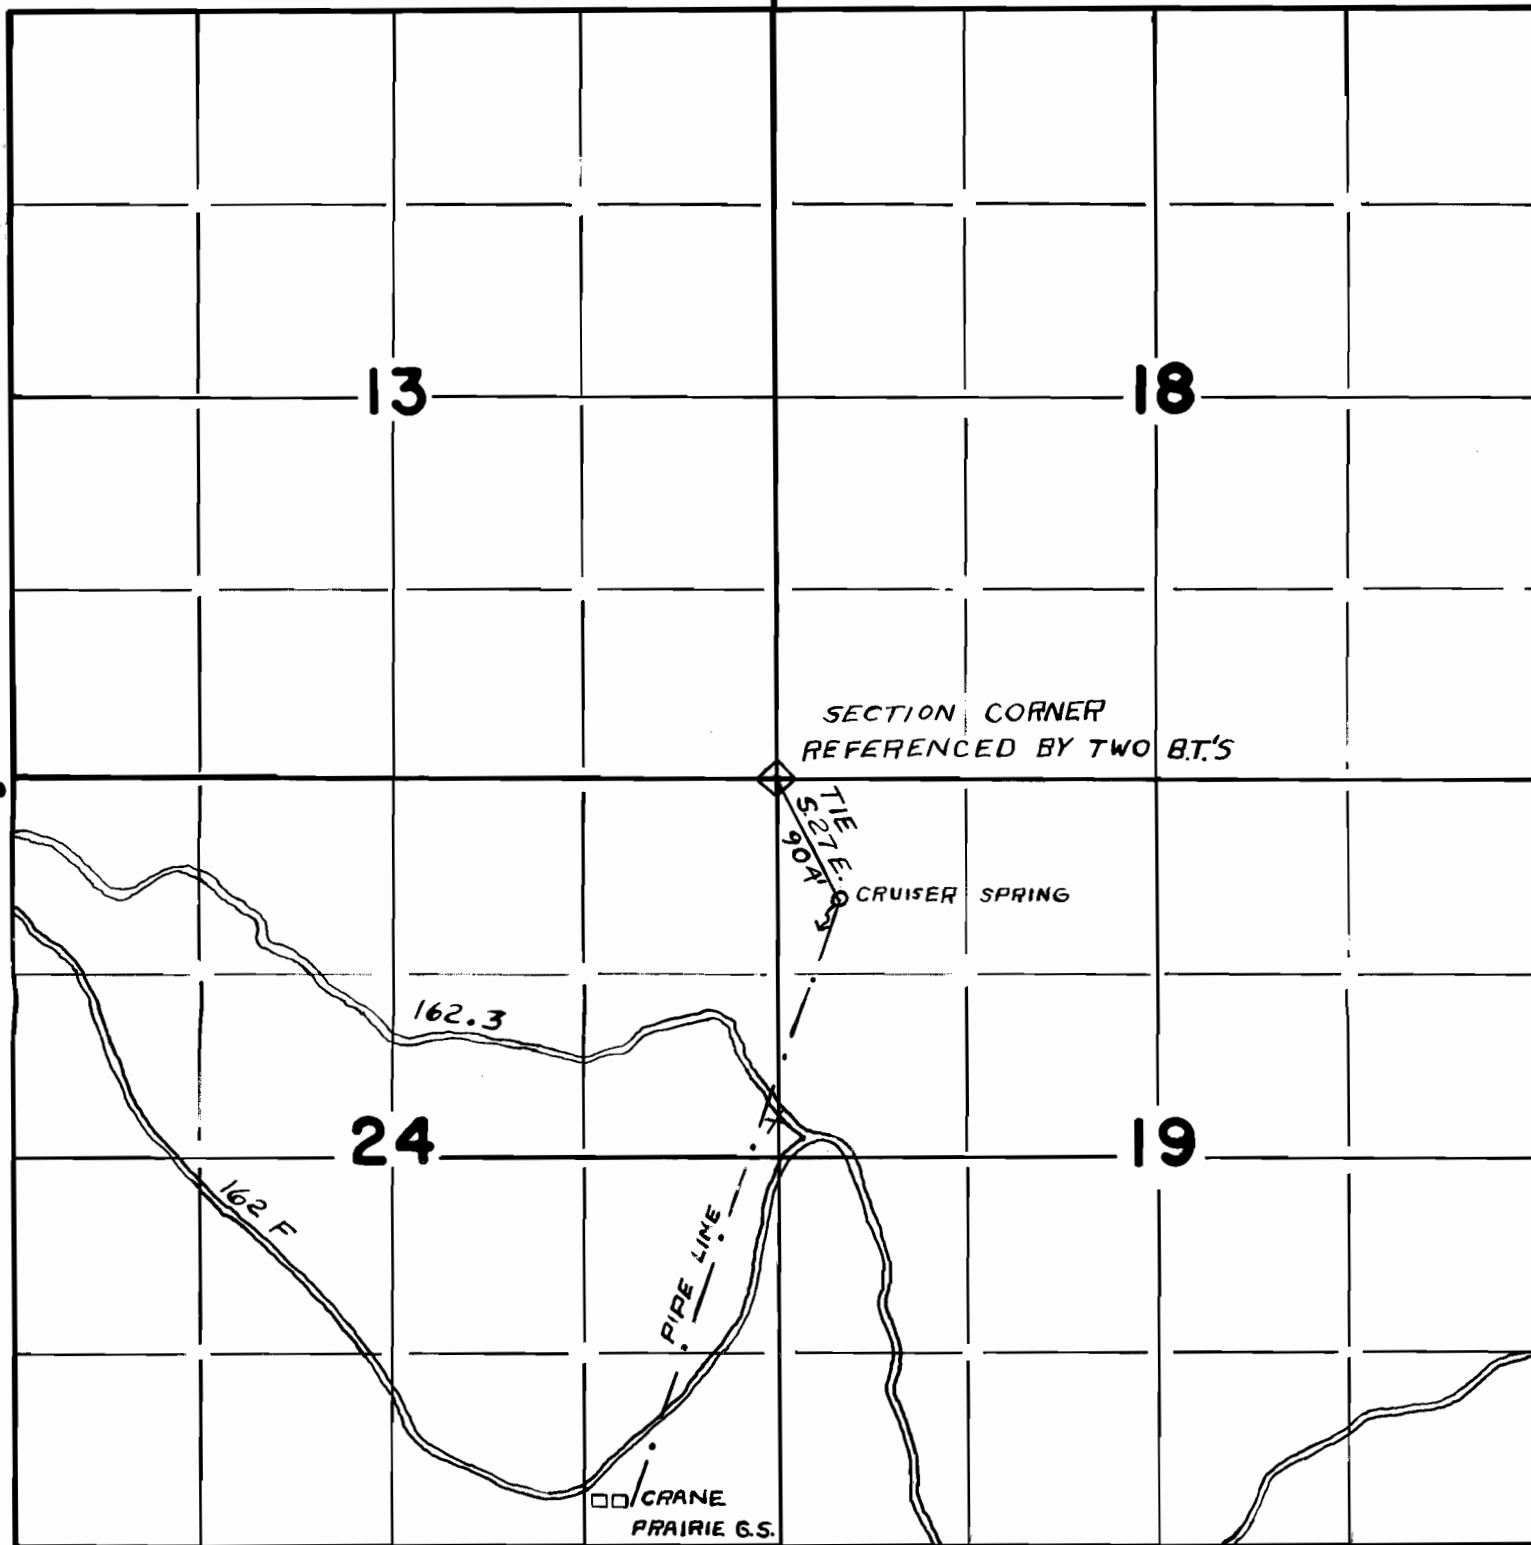

SCALE 4" = 1 MILE

Application No. 27201
Permit No. 28013

DIVERSION FROM SPRING THROUGH PIPE LINE FOR DOMESTIC USE IN CRANE PRAIRIE CAMP WITHIN SE 1/4 SE 1/4, SECTION 24, TOWNSHIP 16 SOUTH, RANGE 34 EAST, W.M. SPRING IS SOUTH 27° EAST, 904 FEET FROM NORTH WEST CORNER OF SECTION 19

PRAIRIE CITY RANGER DISTRICT
MALHUER NATIONAL FOREST