


T.37S.R.10E.W.M.

Swan Lake wells

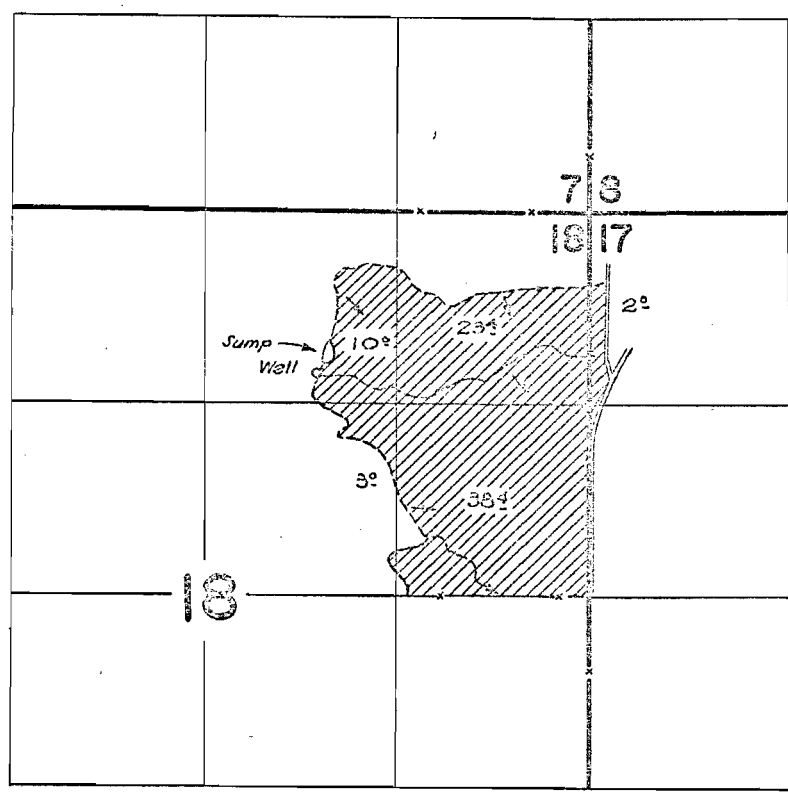

FINAL PROOF SURVEY UNDER

Application No. U-501... Permit No. U-585...
IN NAME OF

MARIO MARENGO

Surveyed August 16 1962, by Carl Baker...

Handwritten initials