


T.16S.R.5W.W.M.

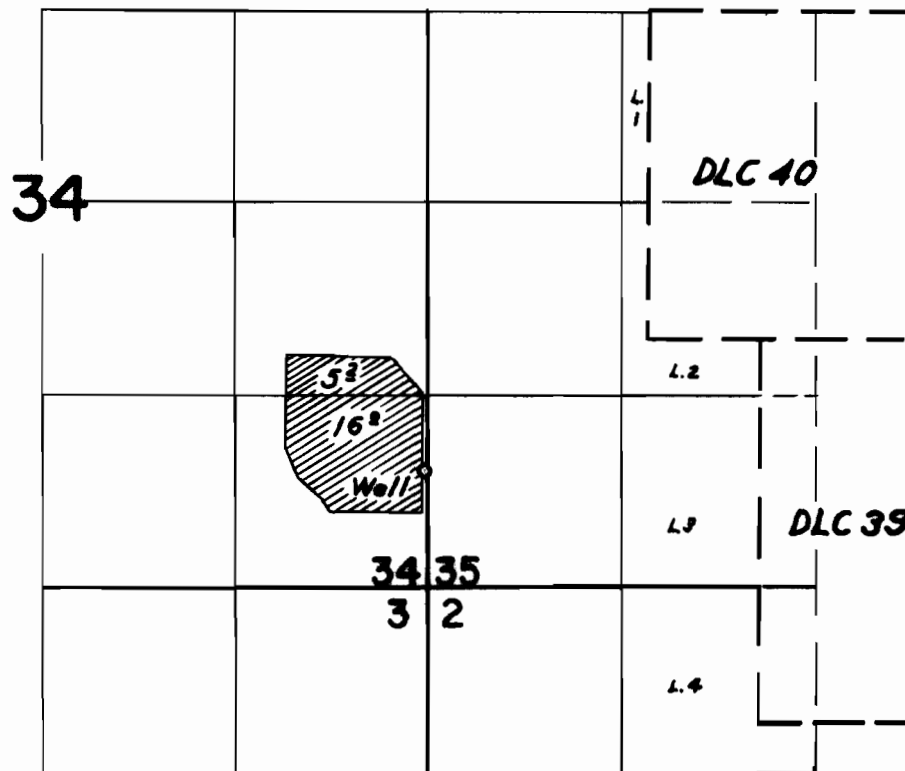

FINAL PROOF SURVEY
UNDER

Application No. G-1518 Permit No. G-1399
IN NAME OF

Willard Berg

Surveyed May 7 1962, by Thomas R. Lauer