


T.16S.R.3W.W.M.

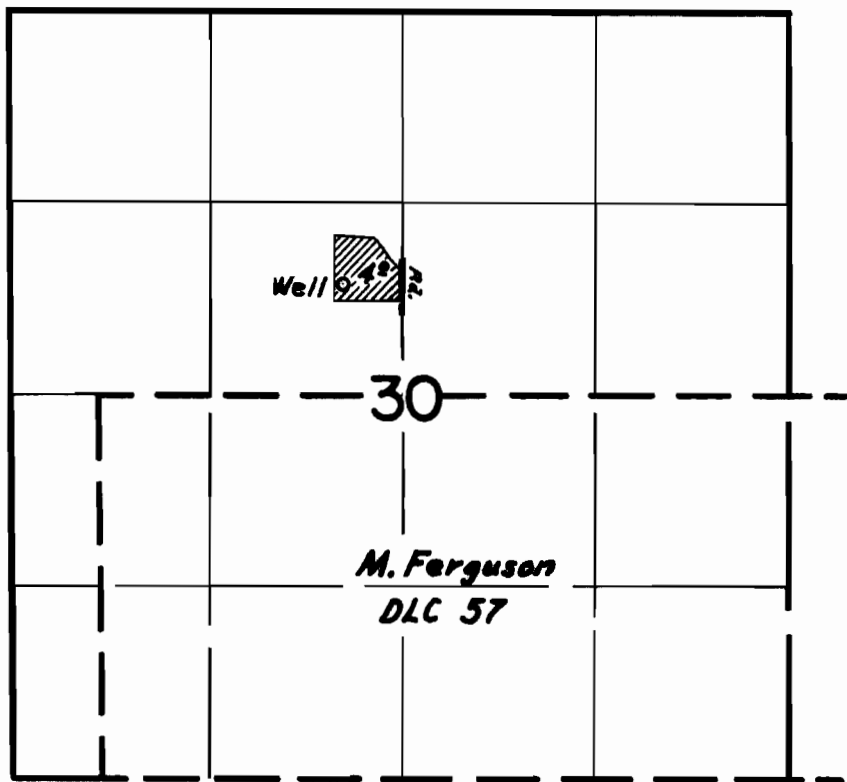

FINAL PROOF SURVEY
UNDER

Application No. *G-1767* Permit No. *G-1619*
IN NAME OF

C. A. Stallings

Surveyed *May 3* 19*62*, by *Thomas R. Lauer*