


Eugene District
Bureau of Land Management

T. 18S R. 8W S. 21

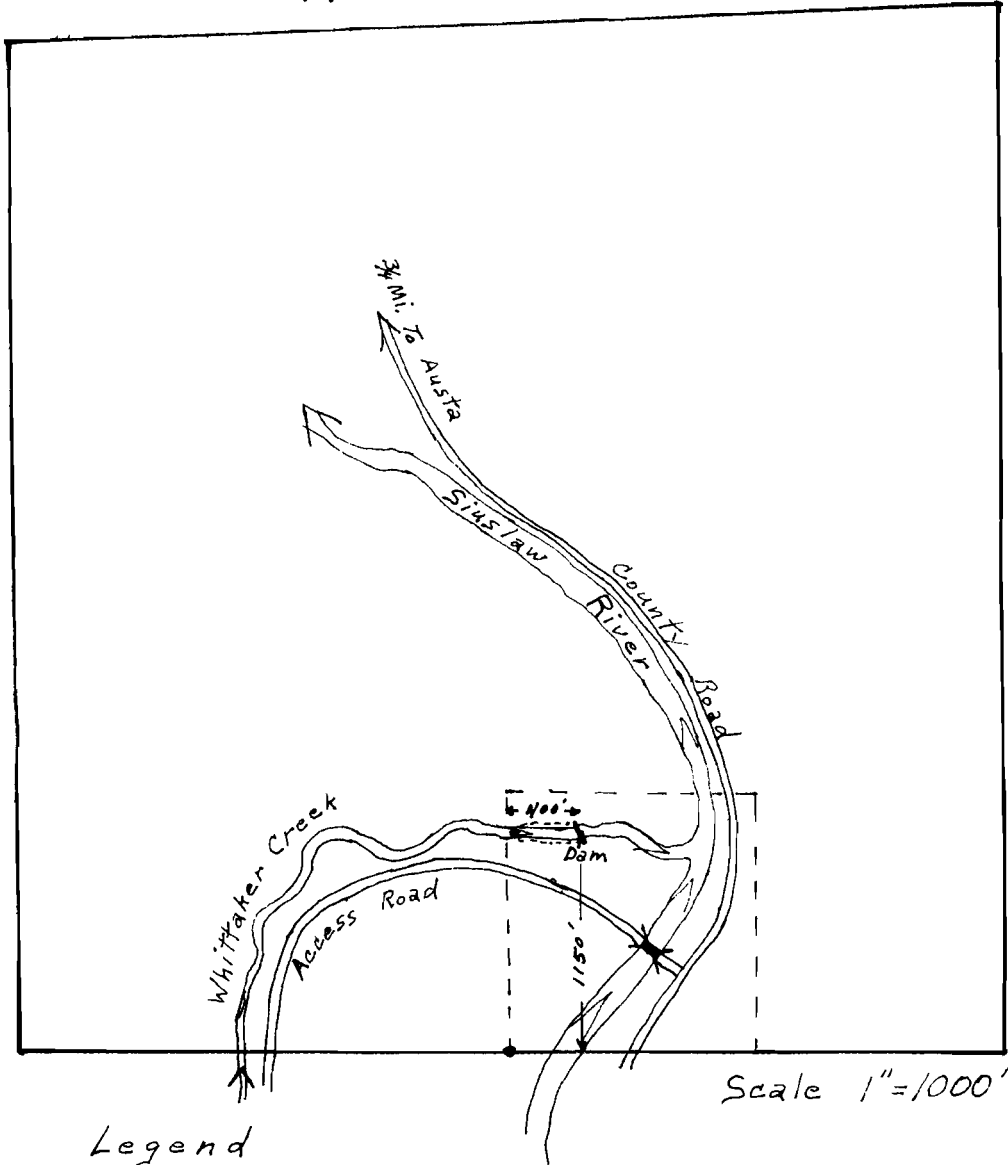

Legend
----- Dam + Pond

Application No. R-36097
Permit No. R-2645