

14 13
23 24
Found I.P. # B.T.
Woahink Lake

Found 2" I.P. # B.T.
Center Section 23

N. 89° 31' 10" E
1458.42

Deed = 1873.37 West

1/16 Corner.
Found 2" I.P.,
C.S. Stake #
C.S. B.T.'s

N 89° 54' 40" E
1309.66

1/4 corner
between
Sec. 23 & 24

0 n. 59° 00' w

Deed = 351.28 South

2693.10
E 1/2 S

Deed = 320.50 East

Spring

Deed = 256.30 S. 30° 45' W.

Deed = 230.0 East

Spring

DAM
7255 + 550E

NW 1/4, SE 1/4

Deed = 916.8 N. 1° 00' W.

Deed = 777.8 S. 30° 45' W.

Pump Pipe TANK
7.70 A.C.T.

House

SOLD.

Deed = 104.2 S. 67° 48' W.

Scale 1" = 100'
March, 1957

S.W. corner of NW 1/4, SE 1/4
Found I. Pin
Set for 1/16 Corner

1368.70
S. 89° 17' 50" W
1.57 A.C.T.

Deed = 317.20 S. 71° 47' W
317.47 - S. 70° 24' 30" W.

Found I.P.

SW 1/4, SE 1/4

Found I.P.,
South 7, 111.98' &
West 1, 719.53' of
N.E. corner Sec. 23.

Found 3" I.P.
Set For 1/16
Corner, S.E. corner
of NW 1/4, SE 1/4.


Found C.S.
1/16 corner

M. 08.05 of S
1336.02


M. 51.4E of S
1368.60

M. 08.30 of S
50° 30' S

23 24
26 25

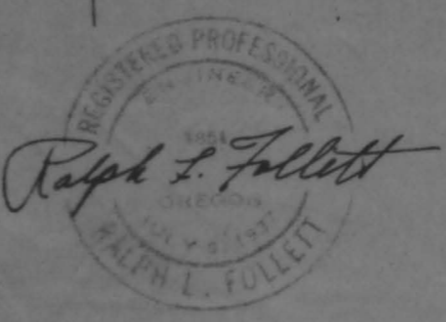

C. C. WILSON

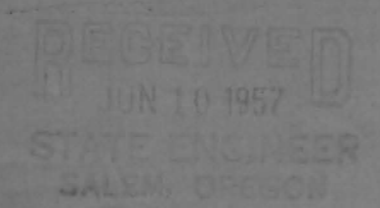

IN SEC. 23, T.19S., R.12W., WM., LANE COUNTY, OREGON

R. L. FOLLETT
Engineering & Surveying
15 Ascot Drive
Eugene, Oregon

Application No. 31623
Permit No. 25140