


T. 19S. R. 2W. W. M.

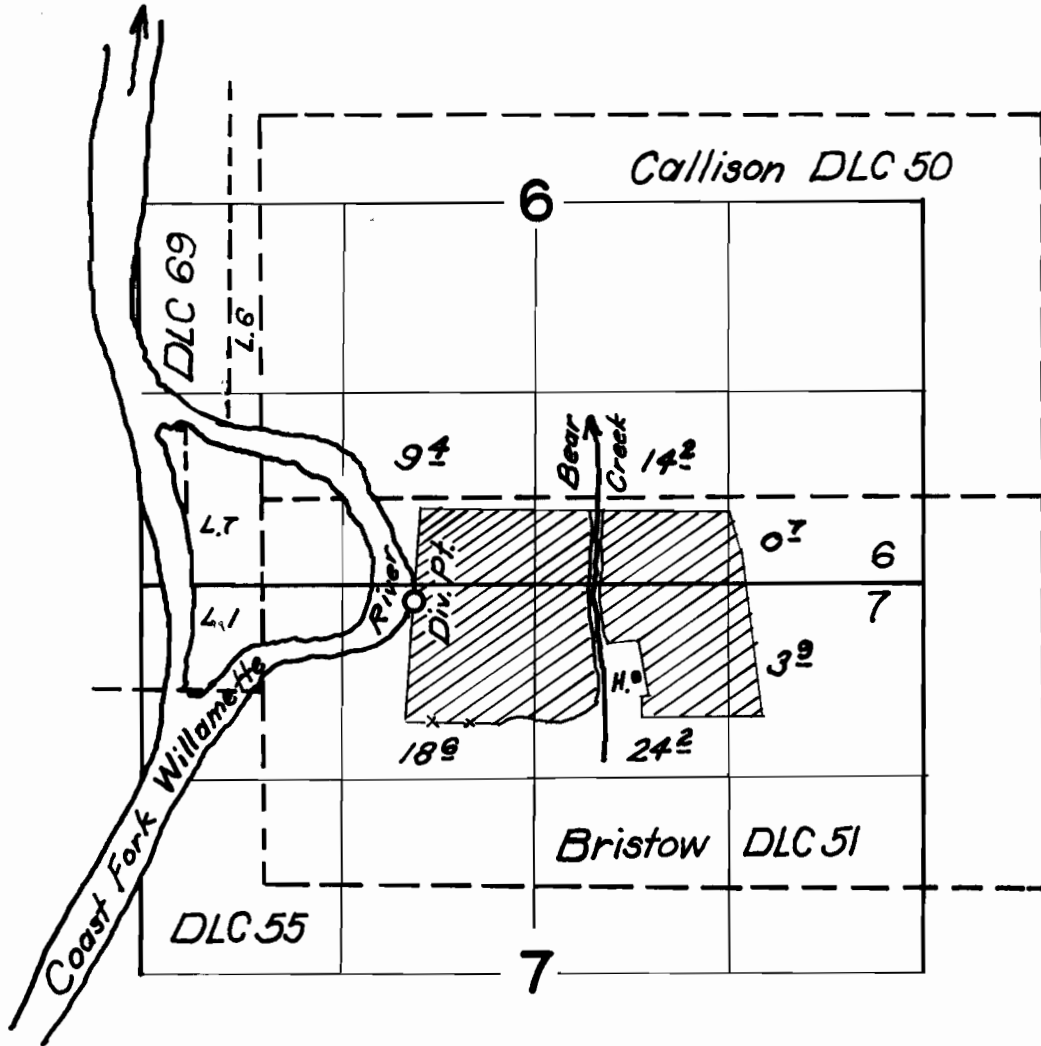

**FINAL PROOF SURVEY**  
UNDER

Application No. *32363* Permit No. *25556*  
IN NAME OF

*Albert J. Ellison*

Surveyed *April 25 1962*, by *Carl R. Baker*