


# T.16S.R.5W.W.M.

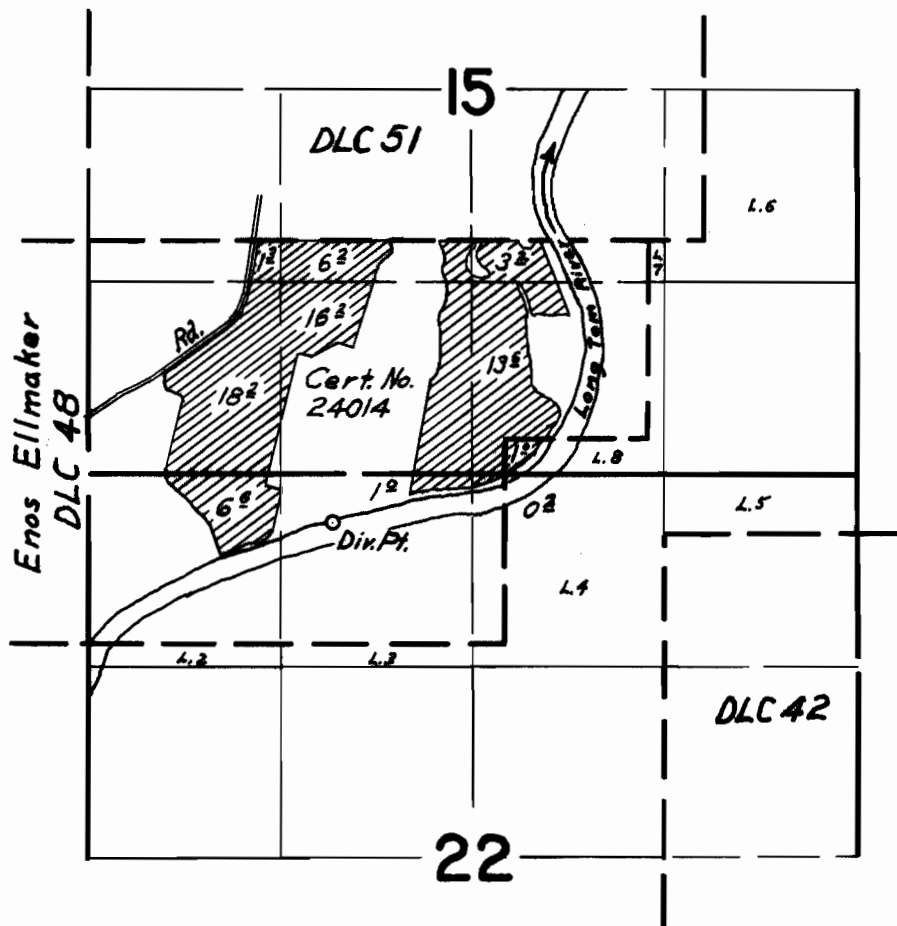

## FINAL PROOF SURVEY UNDER

Application No. 33567..... Permit No. 26557.....  
IN NAME OF

.....Robert Alvin Siewert.....

Surveyed May 4... 1962., by Thomas R. Lauer