


T.16S.R.4W.W.M.

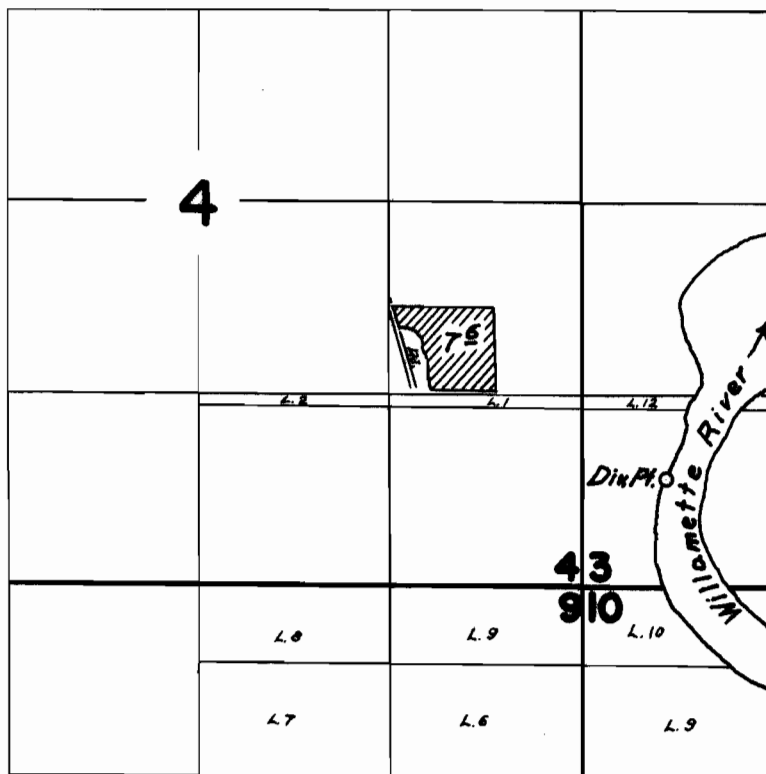

FINAL PROOF SURVEY UNDER

Application No. 33870... Permit No. 26697...
IN NAME OF

.....Jesse Harper.....

Surveyed May 2..... 1962., by Thomas B. Lauer