


T.16S.R.2W. W.M.

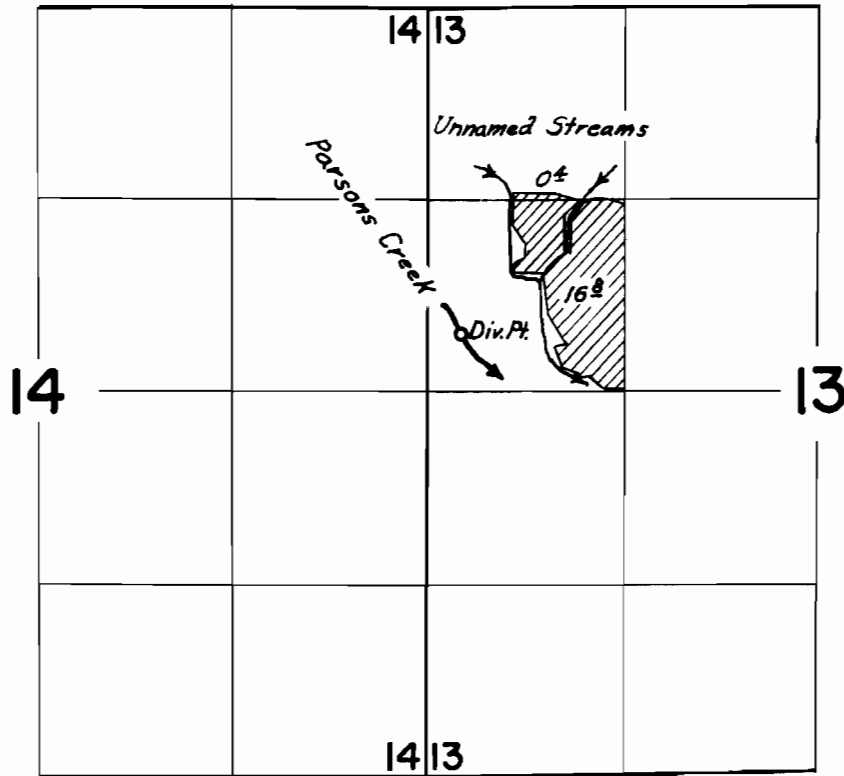

FINAL PROOF SURVEY
UNDER

Application No. 34692 Permit No. 27257
IN NAME OF

Calvin P. Rose

Surveyed May 10 1962, by Thomas R. Lauer