


T. 11 S. R. 8 W. W.M.

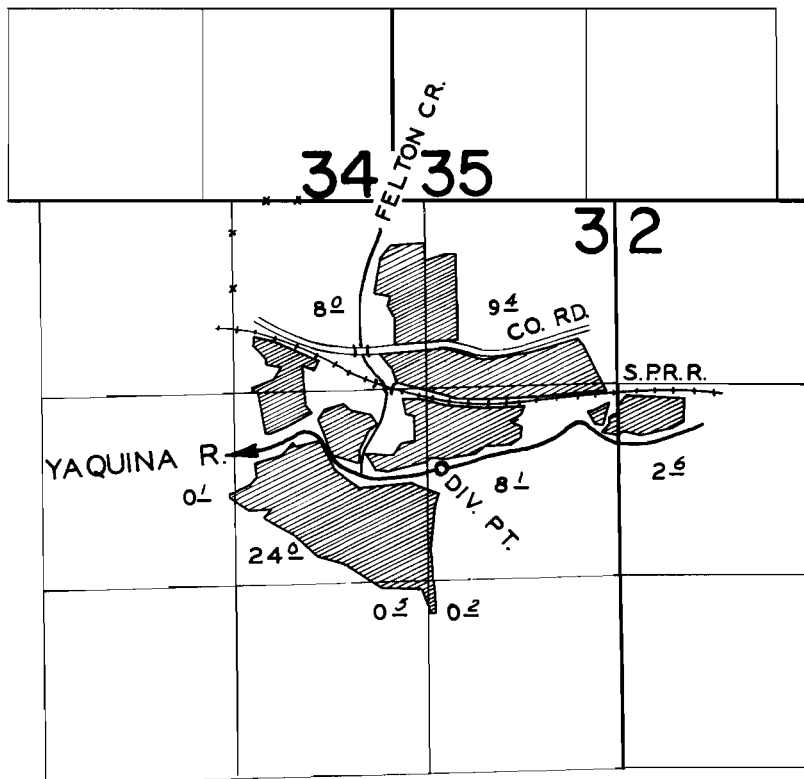

FINAL PROOF SURVEY
UNDER

Application No. 34968 Permit No. 21424
IN NAME OF

WM. HENRY ANDERSON

Surveyed AUG. 12 1960, by R. H. JACKSON