


T.12S. R. 4W.W. M.

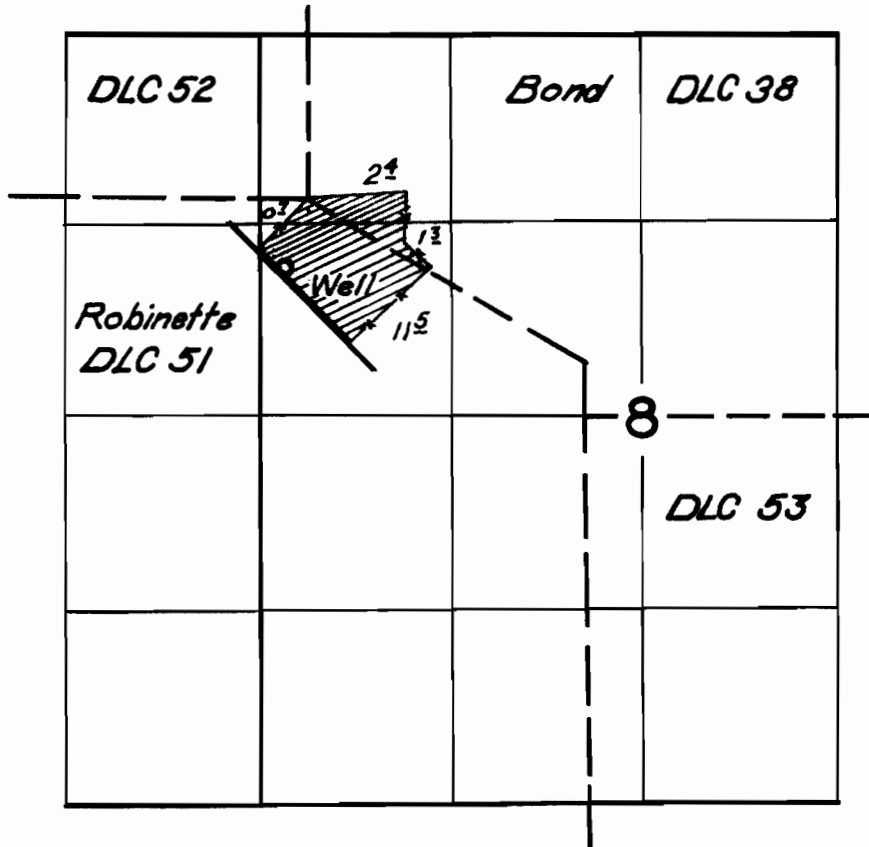

FINAL PROOF SURVEY
UNDER

Application No. *G-468* Permit No. *G-347*
IN NAME OF

John & Frances Udden

Surveyed *5 April 1962*, by *Carl R. Baker*