


T.15S.R.4W.W.M.

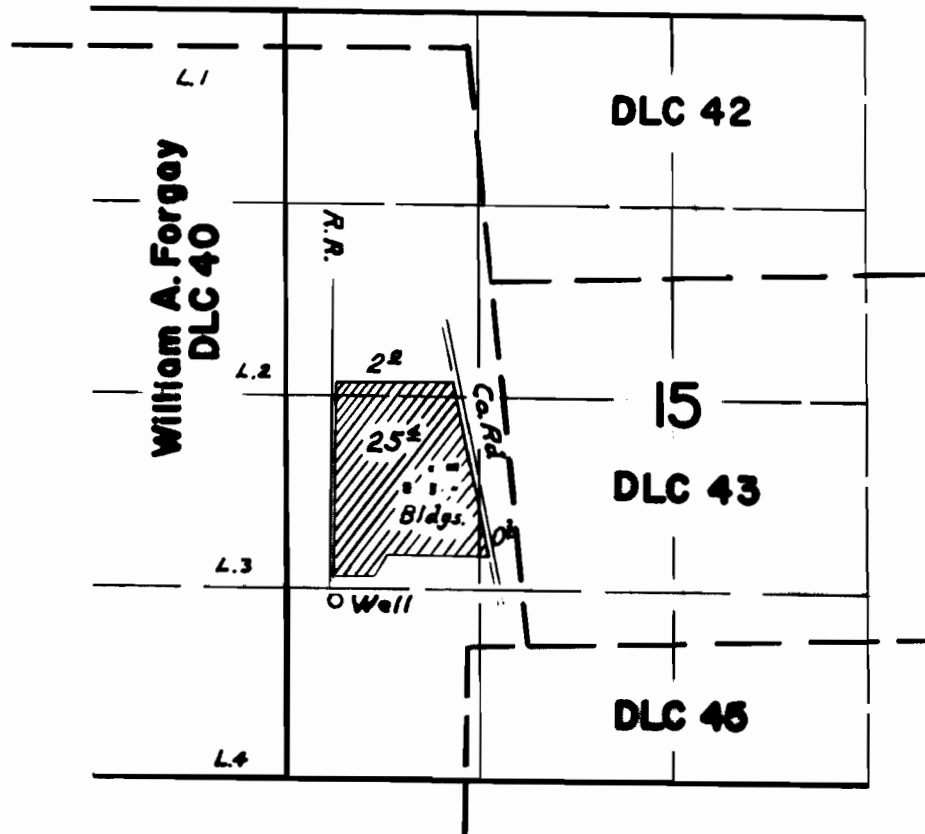

FINAL PROOF SURVEY
UNDER

Application No. G-1160 Permit No. G-916
IN NAME OF

Ronald E. McNutt

Surveyed April 5, 1962, by Thomas R. Lauer