


T.12S. R.2 W.W. M.

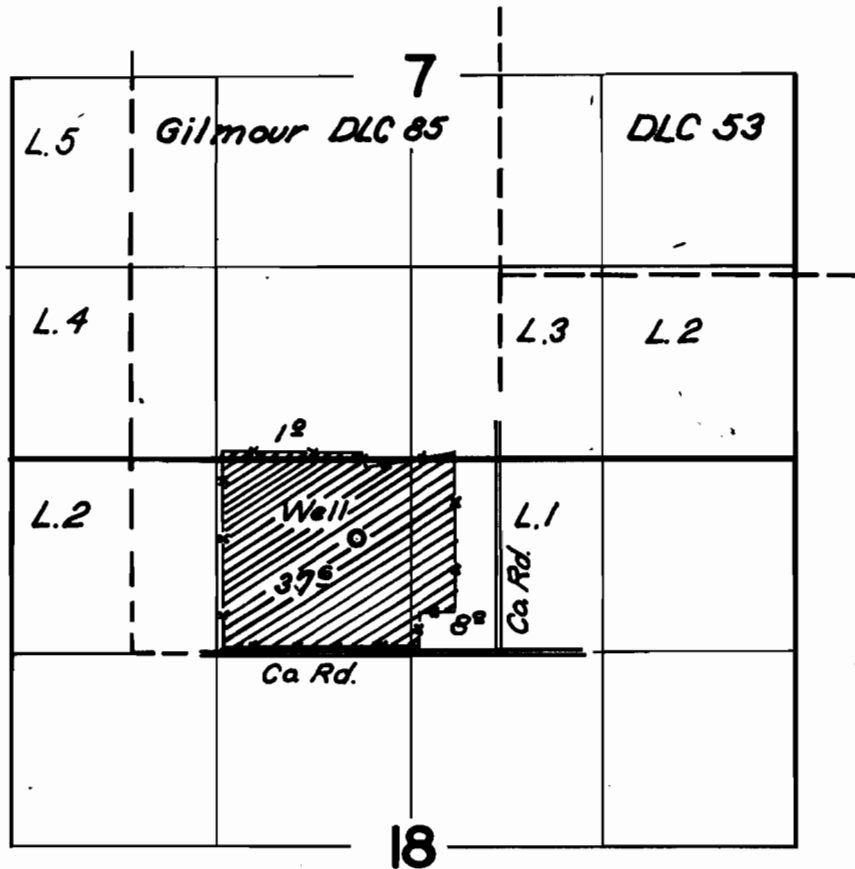

FINAL PROOF SURVEY
UNDER

Application No. G-1344 Permit No. G-1212
IN NAME OF

Henry & Hildred DeManette

Surveyed 6 April 1962, by Carl R. Baker