


# T. 9S. R. 1W. W.M

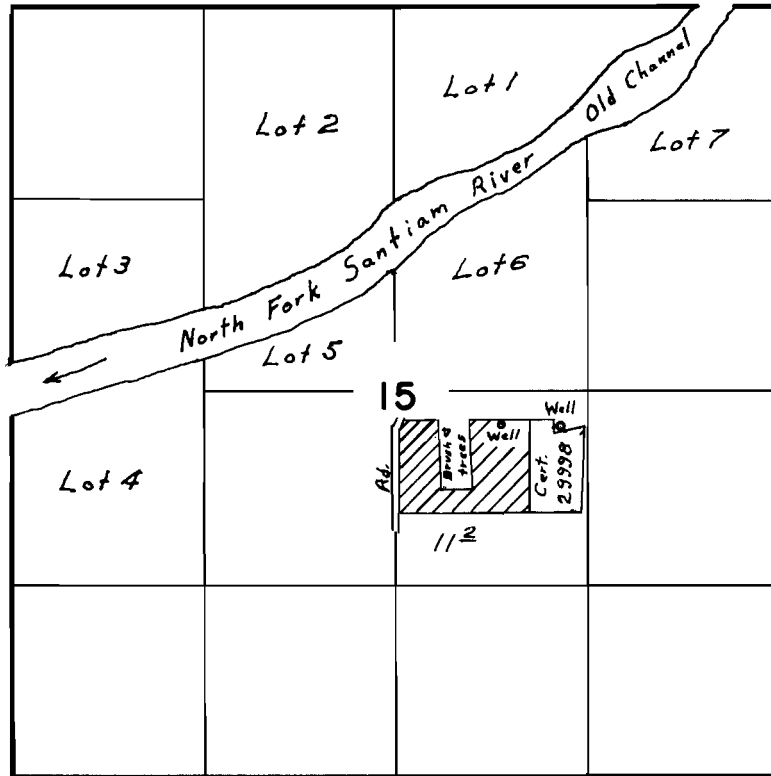

## FINAL PROOF SURVEY UNDER

Application No. G-1572 Permit No. G-1434  
IN NAME OF

Dewitt Tiger

Surveyed March 27 1962, by Thomas A. Lauer  
T.A. Lauer