


# T.I.S. R. 2 W. W. M.

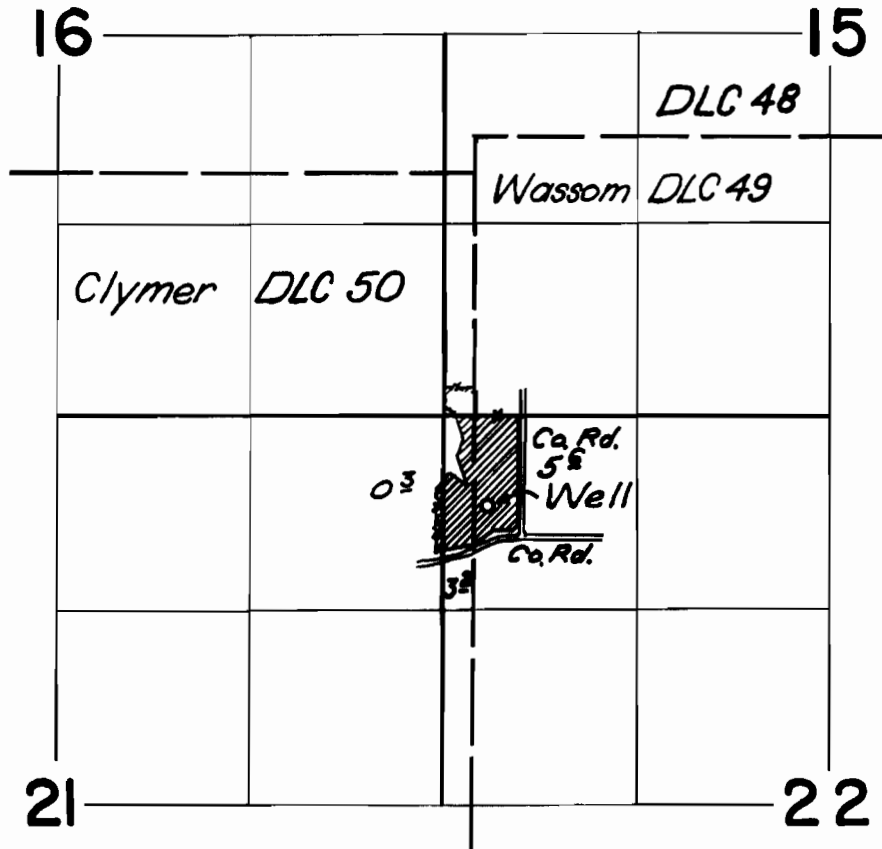

## FINAL PROOF SURVEY UNDER

Application No. *G-1810* Permit No. *G-1655*  
IN NAME OF

*Gordon & Goldie Horst*

Surveyed *29 Mar. 1962*, by *Carl R. Baker*