


T.11 S R.2 W.W.M.

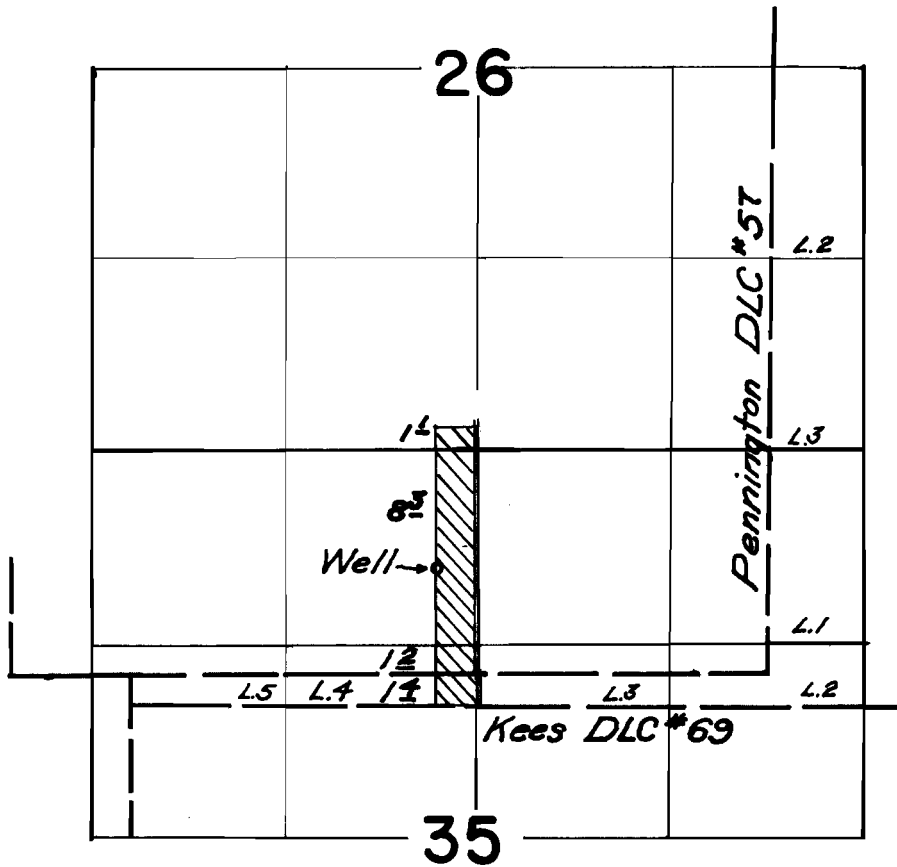

FINAL PROOF SURVEY  
UNDER

Application No. ~~61909~~ Permit No. ~~61758~~  
IN NAME OF

*James Pesek*

Surveyed *27 Mar. 1962*, by *Carl R. Baker*