


T.9S.R.3E.W.M.

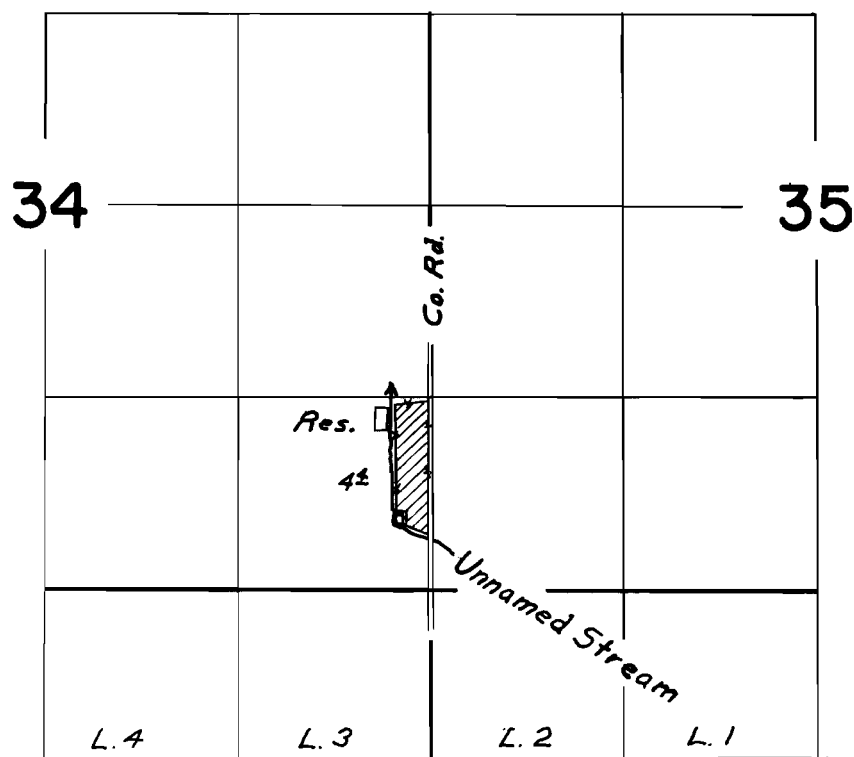

FINAL PROOF SURVEY
UNDER

Application No. R-29783 29784 Permit No. R-1719 23448
IN NAME OF

Roseland E. + Willard M. Howell

Surveyed April 2, 1962, by Thomas R. Lauer