


T.13S. R.1W.W.M.

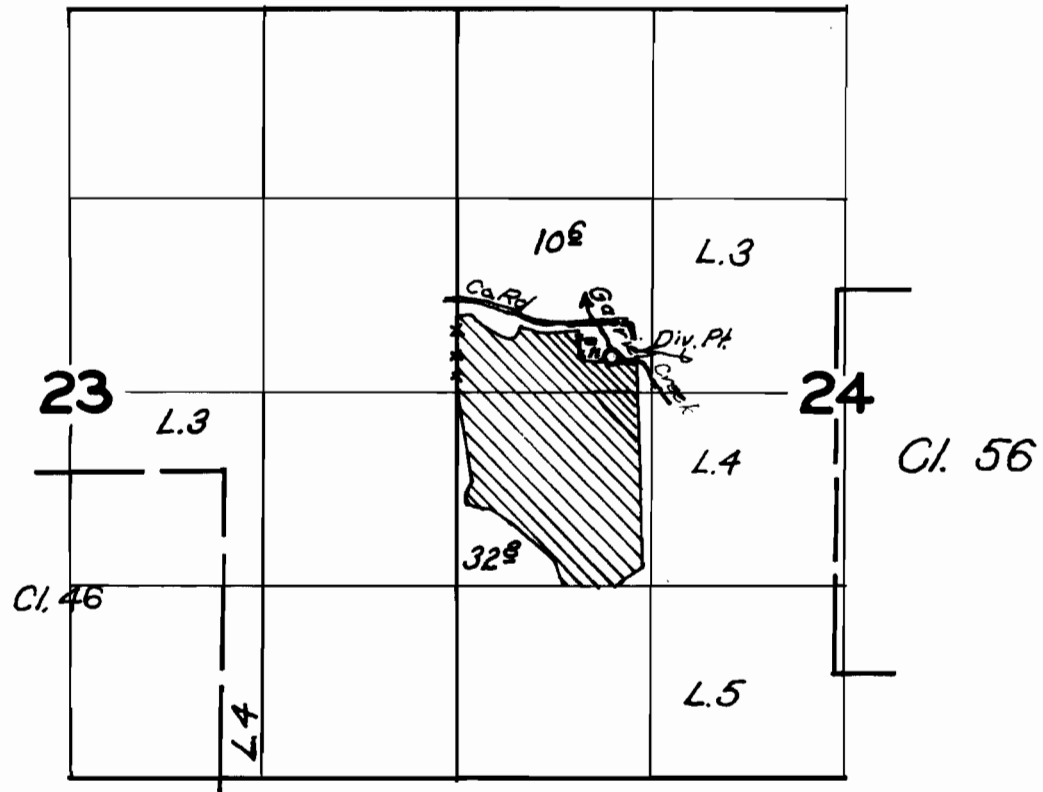

FINAL PROOF SURVEY
UNDER

Application No. 34106 Permit No. 26882
IN NAME OF

Dan & Dorothy Roth

Surveyed 2 April 1962, by Carl R. Baker